

Name **StreetView Realty**

Service No. **96**

Address **41 Valleyfield Street**

41 Valleyfield Street

Location

Kind of Pipe

Size **6"**

Size of Main **8"**

Repair—Renewal—New Service **Valeri #1745**

Location **DEC 31 1970**

Date	Material	Amount	Total	Date	Amount	
11 '66	26' 6" Transite pipe @ 5.00		120.00	10-3-70	Deposit	165.48
10/20/67	Labor	28.72				
	10% OYH	2.87	31.59			
	3' 6" Transite pipe @ .29	.88	2.67			
	1/2 Hr. Trucking @ 3.00		1.50			
	1 1/2 Hr. Shovel @ 6.50		9.75			
			165.48			
	BILL WHEN CONNECTED		165.48			
1/70	29' 6" Transite pipe					
	10' 4" Cast Iron pipe					


DATE _____

TOWN OF LEXINGTON — BOARD OF PUBLIC WORKS

SEWER DIVISION

Sketch of Service Here

41

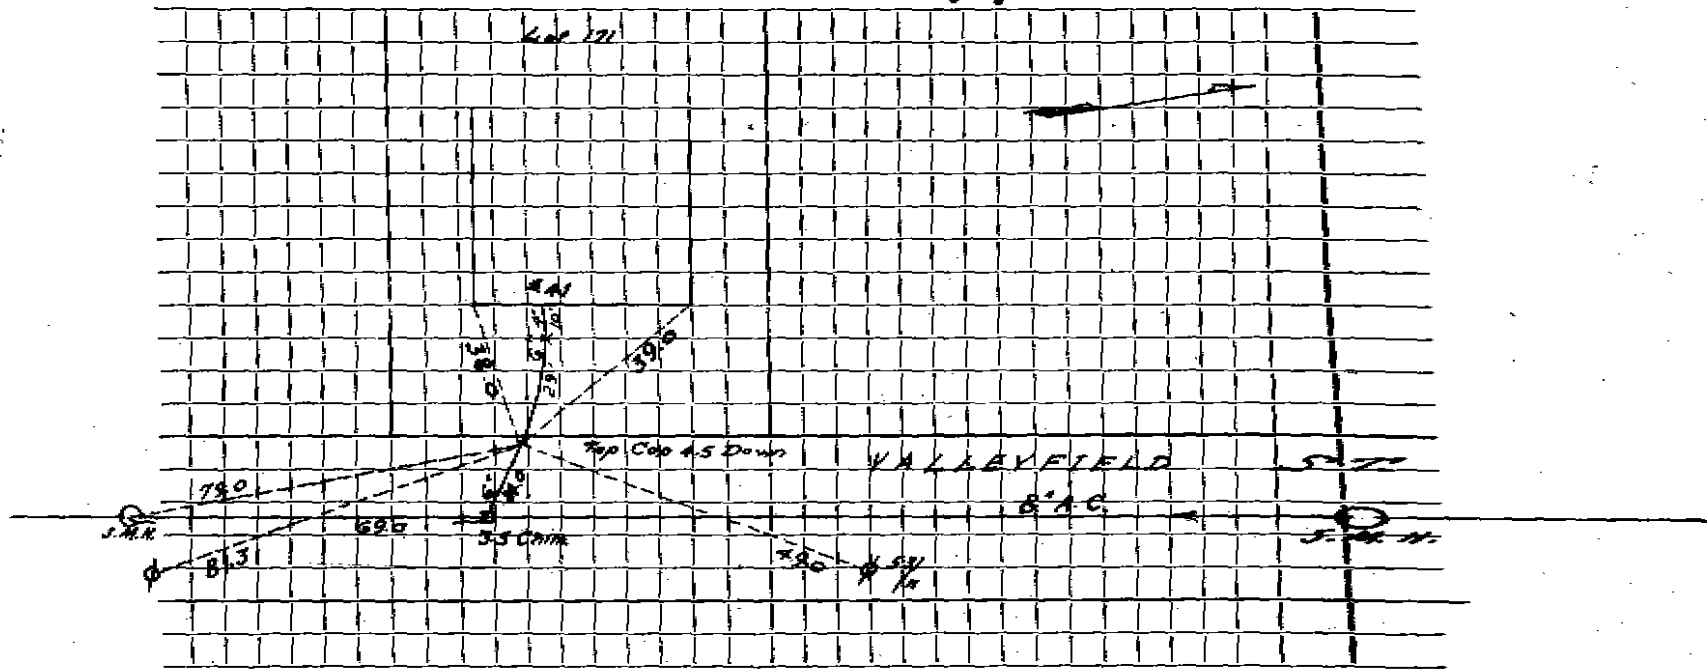

Connection made in Street. Work completed

Remarks: