

Name ~~Dorner~~ Realty

Service No. 192

Address 42 Valleyfield Street

Lot 97 42 Valleyfield Street Location

Kind of Pipe

Size 6"

Size of Main 8"

Repair—Renewals—New Service Valeri #923

Location MAY 13 1968

Date		Material	Amount	Total	Date	Amount
'66	21'	6" Transite pipe @ 5.00		105.00	12-20-67	148.83
1/19/67		Labor		25 62		
		10% O.H.		2 56		
	5'	Transite pipe @ . 33 88		3 96		
	1/2	Hr. Trucking @ 3.00		1 50		
	1 1/2	Hrs. Shovel @ 6.50		9 75		
				148 83		
		BILL WHEN CONNECTED				
21-68	35'	6" Transite pipe				
	10'	4" Cast Iron pipe				

Deposit


DATE _____

TOWN OF LEXINGTON — BOARD OF PUBLIC WORKS

SEWER DIVISION

Sketch of Service Here

42

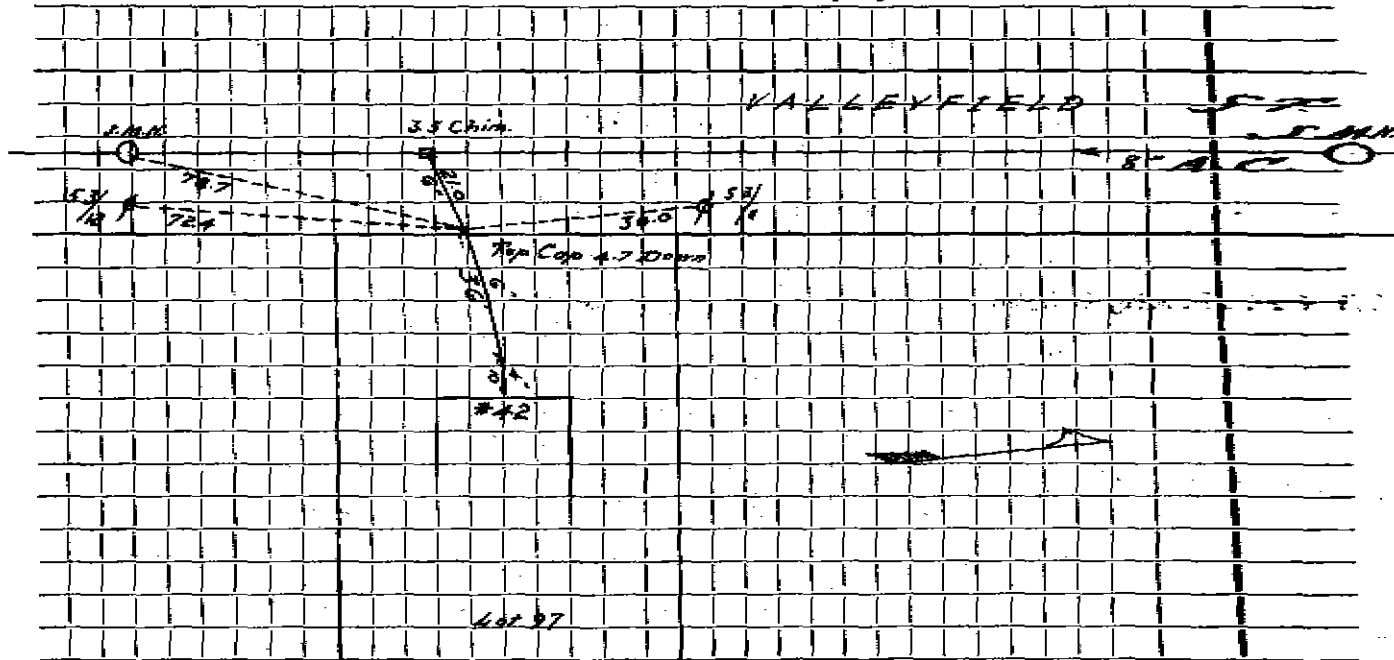

Connection made in Street. Work completed

Remarks:

.....

.....