

Name **StEEVERn lalty**

Service No. **97**

Address **43 Valleyfield Street**

43 Valleyfield Street

Location

Kind of Pipe

Size **6"**

Size of Main **8"**

Repair—Renewal—New Service **Valeri #1746**

Location **DEC 31 1970**

Date	Material	Amount	Total	Date	Amount
'66 21	6" Transite Pipe @ \$5.00		105.00	10-2-70	157.32
19/67	Labor	25 62			
	10% O.H.	2 56	28 18		
10'	6" Transite pipe @ 1.77 .88		8 80		
1	1 1/2" Elbow		4 09		
1/2	Hr. Trucking @ 3.00		1 50		
1 1/2	Hrs. Shovel @ 6.50		9 75		
			TOTAL		
	BILL WHEN CONNECTED		157 32		
'/70 28'	6" Transite pipe				
10'	4" Cast Iron pipe				


DATE _____

TOWN OF LEXINGTON — BOARD OF PUBLIC WORKS

SEWER DIVISION

Sketch of Service Here

43

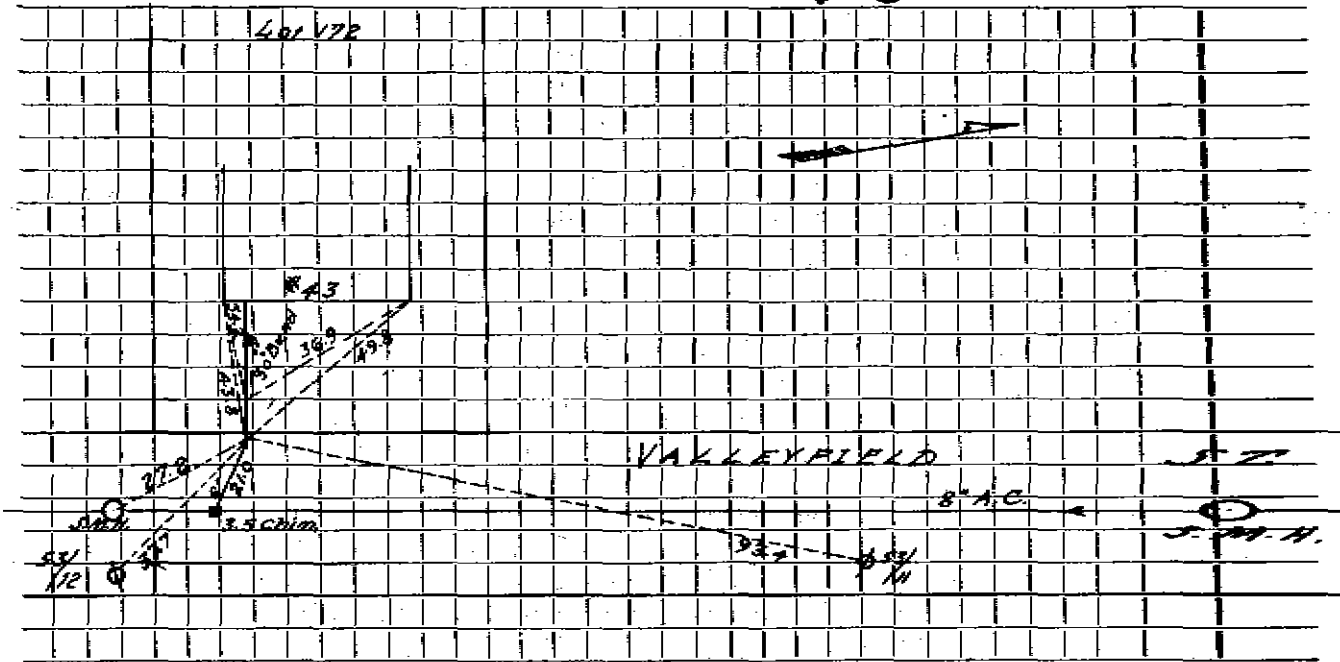

Connection made in Street. Work completed

Remarks:

.....

.....