

Service No.

Name

Address ~~66~~ Wellesfield Street

46 Valleyfield Street

Location

Kind of Pipe

Size 6"

Size of Main 8"

Repair—Renewal—New Service

Location


Date	Material	Amount	Total	Date	Amount
'66 21'	6" Transite pipe @5.00		105.00		

DATE _____

TOWN OF LEXINGTON — BOARD OF PUBLIC WORKS

SEWER DIVISION

Sketch of Service Here **46**

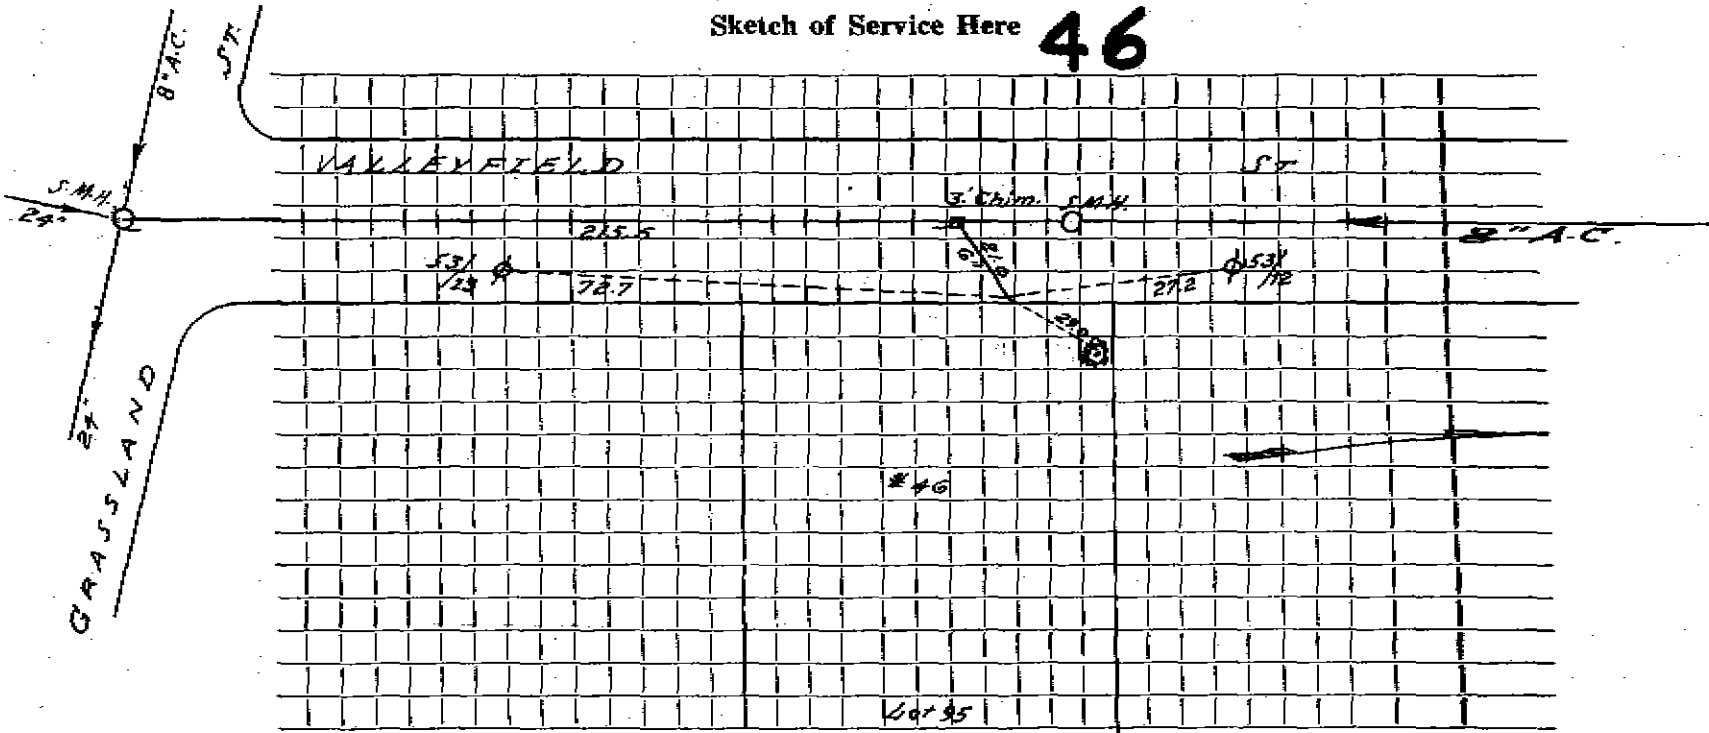

Connection made in Street. Work completed

Remarks:

.....

.....