

Name

Service No.

Address 48 Valleyfield Street

48 Valleyfield Street

Location

Kind of Pipe

Size 6"

Size of Main 8"

Repair—Renewal—New Service

Location


Date		Material	Amount	Total	Date	Amount
1 '66	21'	6" Transite pipe @ 5.00		105.00		
	1/20/67	Labor	28.72			
		10% O.H.	2.87	31.59		
	5'	6" Transite pipe @ 12.88		4.00		
	1	Cap		1.93		
	1/2	Hr. Trucking @ 3.00		1.50		
	1 1/2	Hrs. Shovel @ 6.50		9.75		
				<del>150.22</del>		
		BILL WHEN CONNECTED		150.22		

DATE \_\_\_\_\_

TOWN OF LEXINGTON — BOARD OF PUBLIC WORKS

SEWER DIVISION

Sketch of Service Here **48**

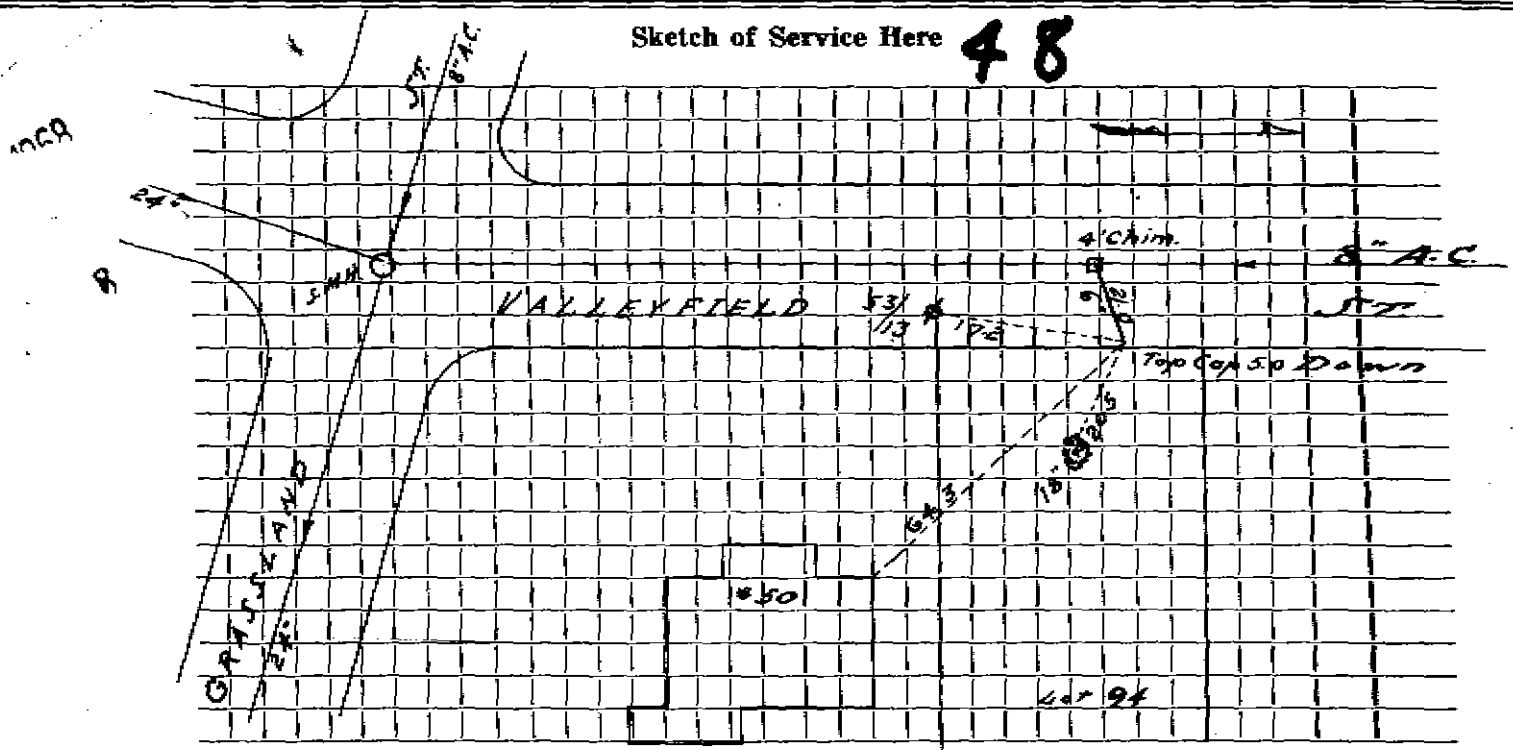

Connection made in ..... Street. Work completed .....

Remarks: .....

.....

.....