

Name Stratvern Realty

Service No. 21

Address 49 Valleyfield Street

49 Valleyfield Street

Location

Kind of Pipe

Size 6"

Size of Main 8"

~~Basic Service~~ New Service W. O. # 7661 Valeri #1567

Location JUL 27 1970


Date	Material	Amount	Total	Date	Amount
5/15/70	Labor	111 48		4-30-70	Deposit 200 00
	10% O.H.	11 15	122 63	7-27-70	Paid by W. O. # 7661 12 78
35'	6" Transitt pipe .90		31 50		212 78
1	6" Plug		3 80		
1	90o Elbow		5 65		
1	Load stone		13 20		
1	Load gravel		14 00		
2	Hrs. trucking 3.00		6 00		
2	Hrs. shovel 6.50		13 00		
1	Hr. dozer		3 00		
			<u>212 78</u>		
3-2-70	28' 6" Transite pipe				
	10' 4" Cast Iron pipe				

DATE _____

TOWN OF LEXINGTON — BOARD OF PUBLIC WORKS

SEWER DIVISION

Sketch of Service Here **49**

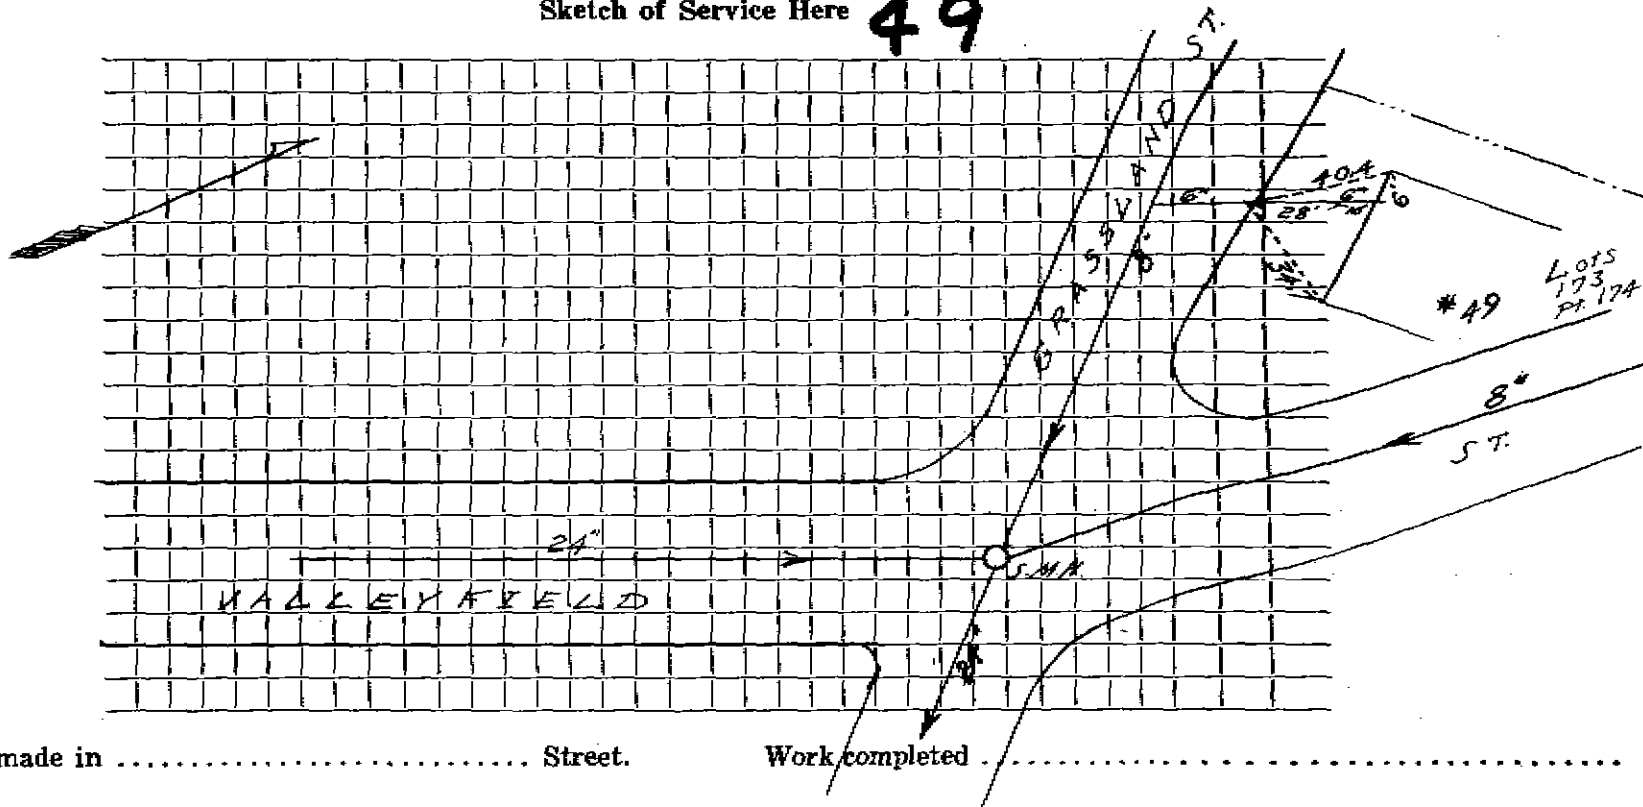

Connection made in Street. Work completed

Remarks:

.....

.....