

Valleyfield St.

Service No.

Address # 57 ~~Valleyfield St.~~

57 Valleyfield Street

Location

Kind of Pipe

Size 6"

Size of Main 24"

Repair—Renewal—New Service

Location


Date	Material	Amount	Total	Date	Location	Amount
	25' 6" TRANS.					
				8-73		
				25' 6" TRANSITE		
				16" Elbow		
				16" 6" Nipple		

DATE _____

TOWN OF LEXINGTON — BOARD OF PUBLIC WORKS

SEWER DIVISION

Sketch of Service Here **57**

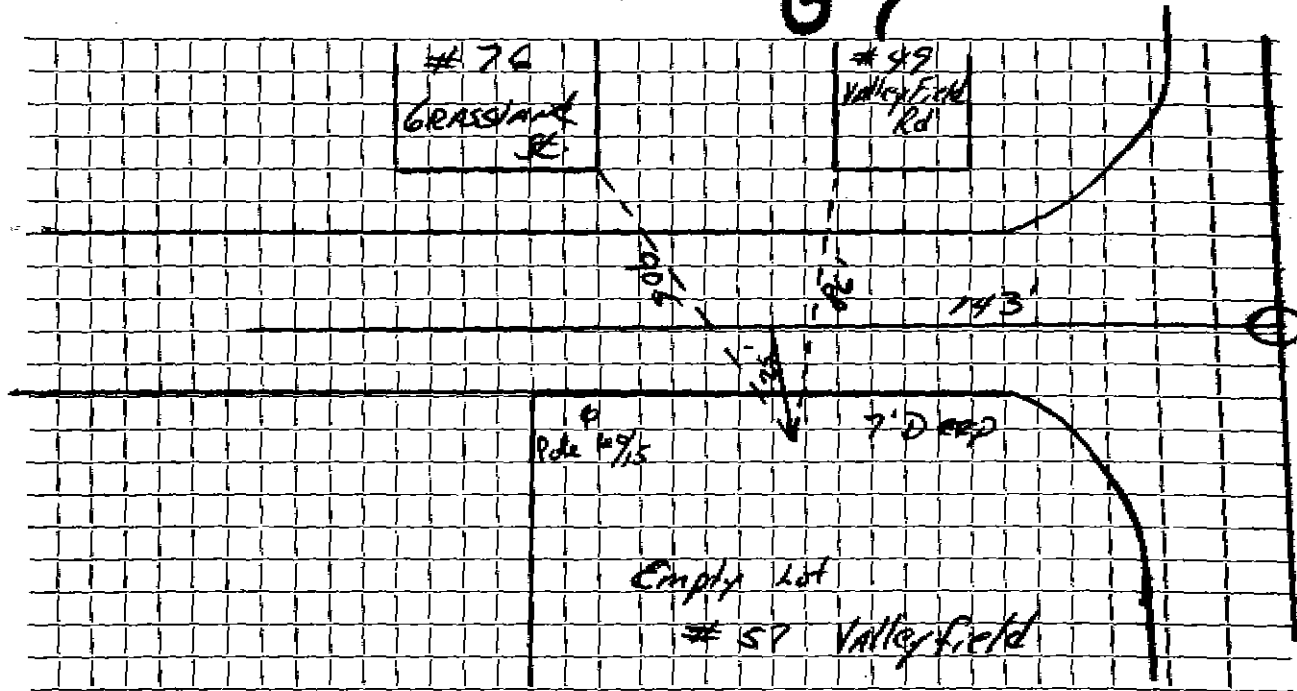

Connection made in Street. Work completed

Remarks:
.....
.....