

Name

Service No.

Address 60 Valleyfield Street

Lot #89 60 Valleyfield Street Location

Kind of Pipe

Size 6"

Size of Main 24"

Repair—Removal—New Service

Location


Date	Material	Amount	Total	Date	Amount
965 23'	6" Transite pipe @7.00		161.00		

DATE _____

TOWN OF LEXINGTON — BOARD OF PUBLIC WORKS

SEWER DIVISION

Sketch of Service Here **60**

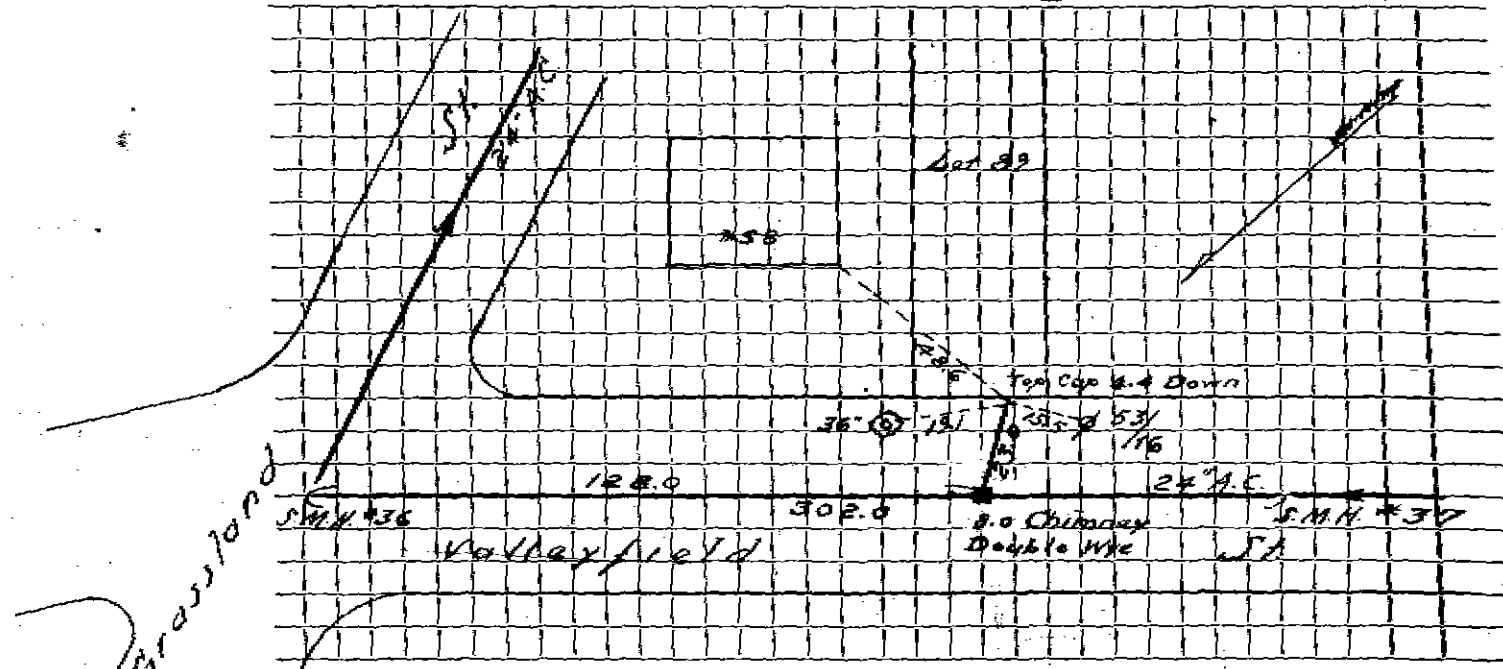

Connection made in Street. Work completed

Remarks:

.....

.....