

Name

Service No.

Address

61 Valleyfield Street

a. 3+94

Lot #44 61 Valleyfield ST. Location

Kind of Pipe

Size 6"

Size of Main

24"

Repair—Renewal—New Service

W.O. #5530

Location

Date	Material	Amount	Total	Date	Amount
4/67	Labor	71 67			
	10% O.H.	7 17	78 84		
	20' 6" Transite pipe @ .88		17 60		
	1 Sweep		2 35		
	1 Cap		1 63		
	½ Bag Cement @ 1.55		77		
	1 Ton ¾" stone		1 65		
	2 Hrs. Shovel @ 6.50		13 00		
	2 Hrs. Trucking @ 3.00		6 00		
8/67	Extended - Labor	52 12			
	10% O.H.	5 21	57 33		
	1 Ton Stone		1 65		
	1 Hrs. Shovel @ 6.50		6 50		
	1 Hrs. Trucking @ 3.00		3 00		
			188 32		


DATE _____

TOWN OF LEXINGTON — BOARD OF PUBLIC WORKS

SEWER DIVISION

Sketch of Service Here

61

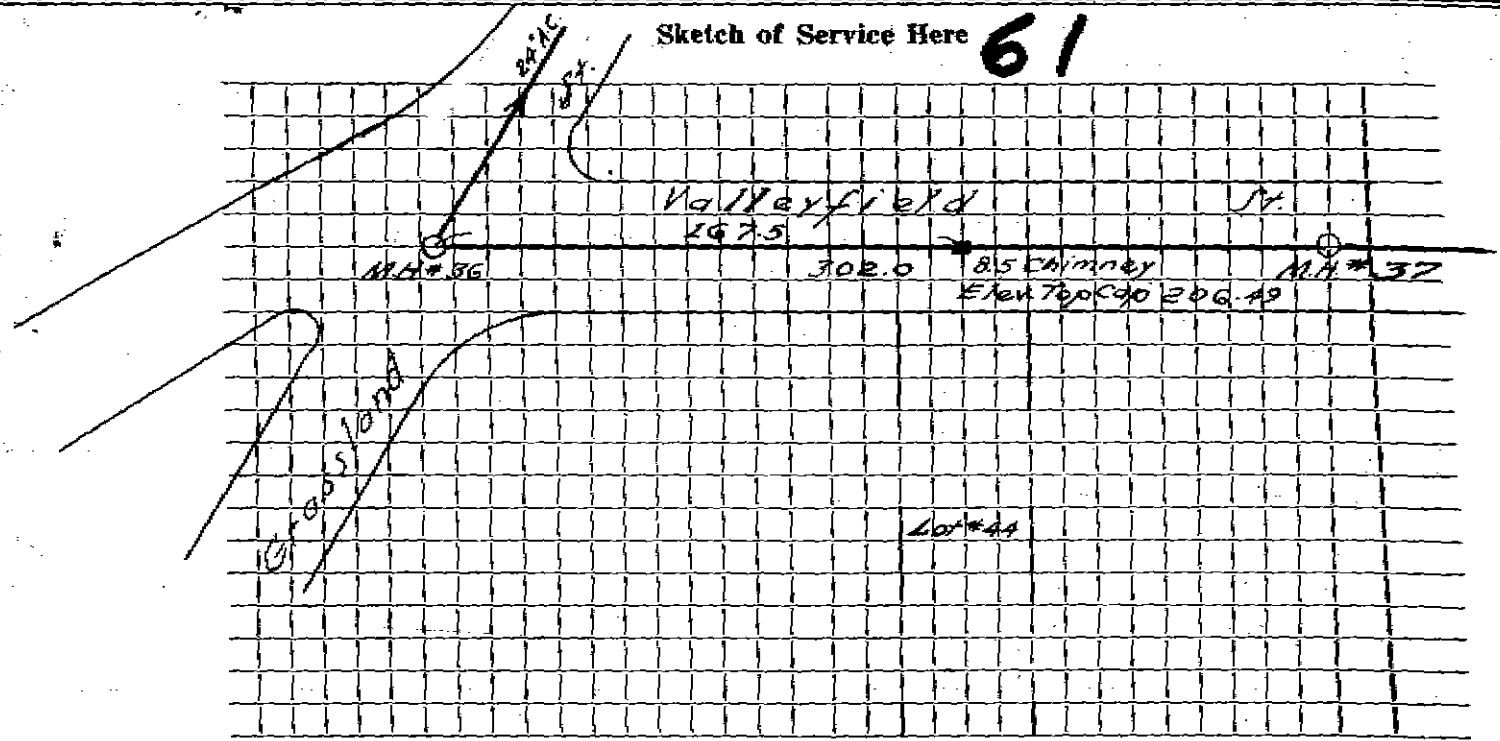

Connection made in Street. Work completed

Remarks:

.....

.....