

Name **George Pioros**

Service No. 81

Address **63 Valleyfield Street**

Plot #45 63 Valleyfield Street Location

Kind of Pipe

Size **6"**

Size of Main **2 1/4"**

Repair—~~Renewal~~—**New Service Valer #2333**

Location **NOV 19 1973**

Date	Material	Amount	Total	Date	Amount	
66	25' — 6" Transite pipe @ 5.00		125 00	8-6-73	Deposit	170 84
9/14/57	Labor		25 62			
	10% O.H.		2 56			
5'	6" Transite pipe @ 3.76 .88		4 40			
1	Adapter		1 62			
1/2	Lb. Cement @ 1.55		39			
1/2	Hr. Trucking @ 3.00		1 50			
1 1/2	Hrs. Shovel @ 6.50		9 75			
			170 84			
	BILL WHEN CONNECTED		170 84			
'73	35' 6" Transite pipe					
	10' 4" Cast Iron pipe					


DATE _____

TOWN OF LEXINGTON — BOARD OF PUBLIC WORKS

SEWER DIVISION

Sketch of Service Here

63

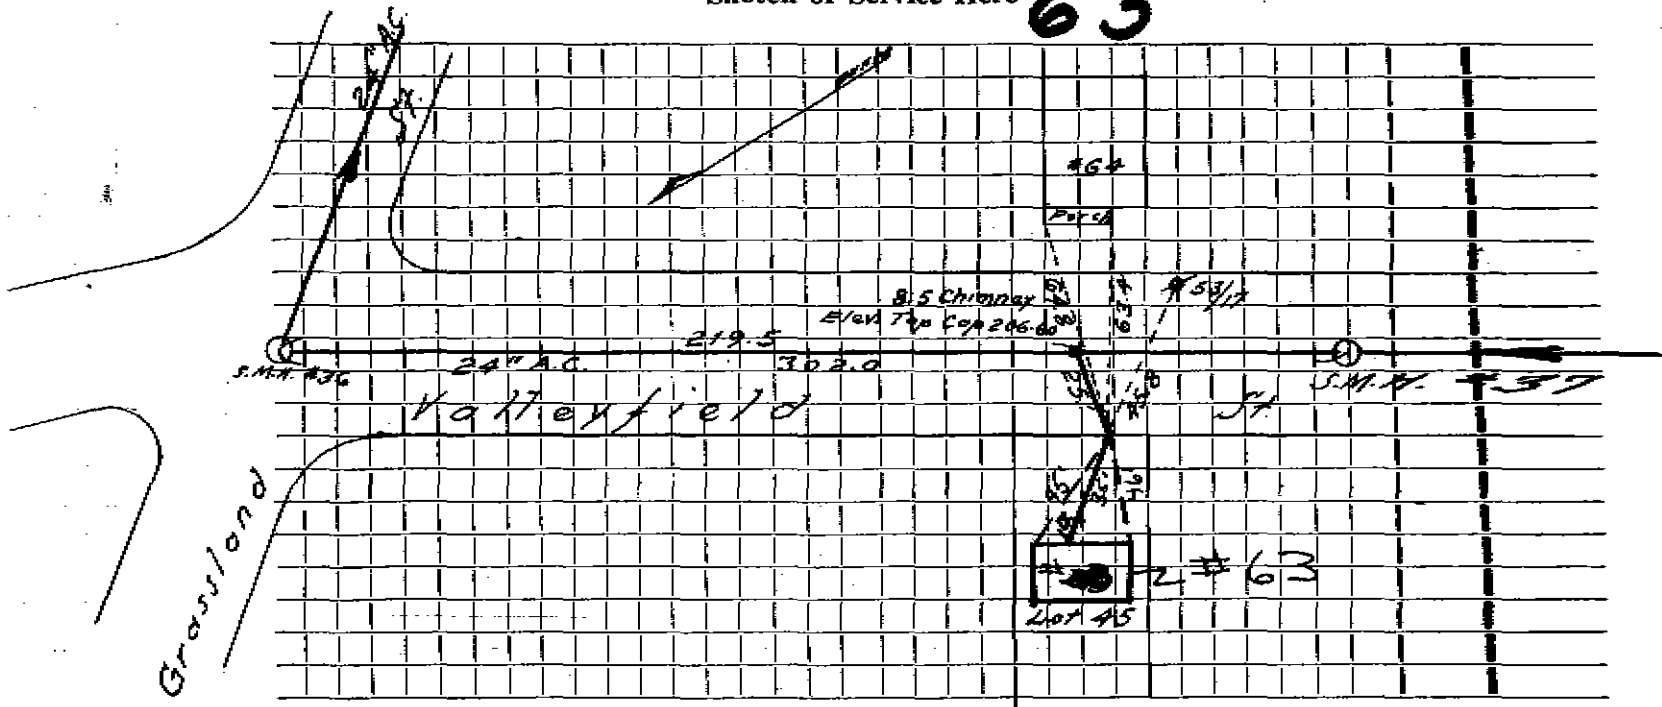

Connection made in Street. Work completed

Remarks: