

Name Peter SOWKO

Service No. 229

Address 64 Valleyfield Street

64 Valleyfield Street

Location

Kind of Pipe

Size 6"

Size of Main 24"

~~XXXXXXXXXXXXXXXXXXXX~~ New Service DeFlice Bros Permit #A81

Location JUL 25 1966

Date	Material	Amount	Total	Date	Amount
23	6" Transit pipe @7.00		161.00	11.10.65	Deposit

18808


DATE _____

TOWN OF LEXINGTON — BOARD OF PUBLIC WORKS

SEWER DIVISION

Sketch of Service Here

64

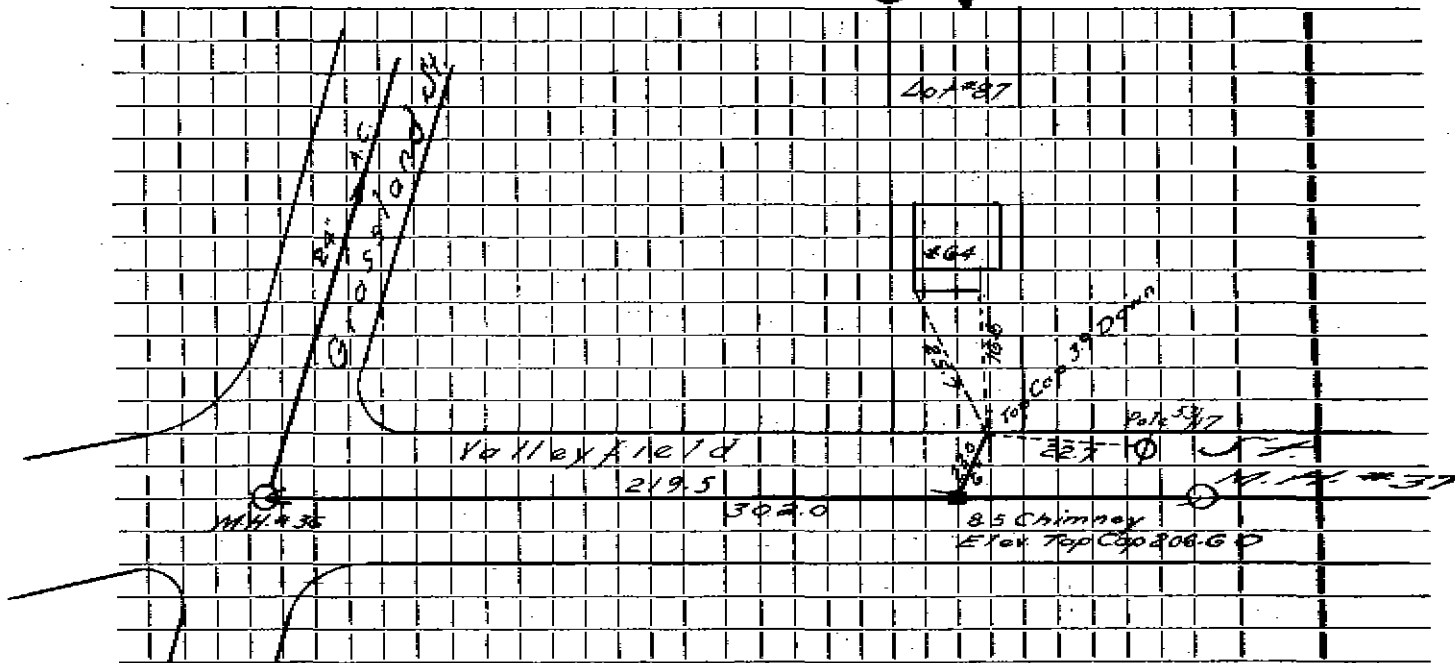

Connection made in Street. Work completed

Remarks:
.....
.....