

Name

Service No.

Address 65 Valleyfield Street

10+0 right Lot #46 65 Valleyfield Street Location

Kind of Pipe

Size 6"

Size of Main 24"

Repair—Renewal—New Service W.O. #5531

Location


Date	Material	Amount	Total	Date	Amount
5/67	Labor	67.55			
5/67	"	43.08			
7/18/67	"	57.44	168.07		
	10% O.H.	16.81	184.88		
	30' 6" transite pipe @ .88		26.40		
	1 22 1/2 Elbow		2.35		
	1 90° Elbow		4.09		
	1 11 1/4 Elbow		2.35		
	1/2 Bag Cambent @ 1.55		33		
7 1/2	Hrs. Shovel @ 6.50		48.75		
6	Hrs. Trucking @ 3.00		18.00		
			287.15		

DATE _____

TOWN OF LEXINGTON — BOARD OF PUBLIC WORKS

SEWER DIVISION

Sketch of Service Here **65**

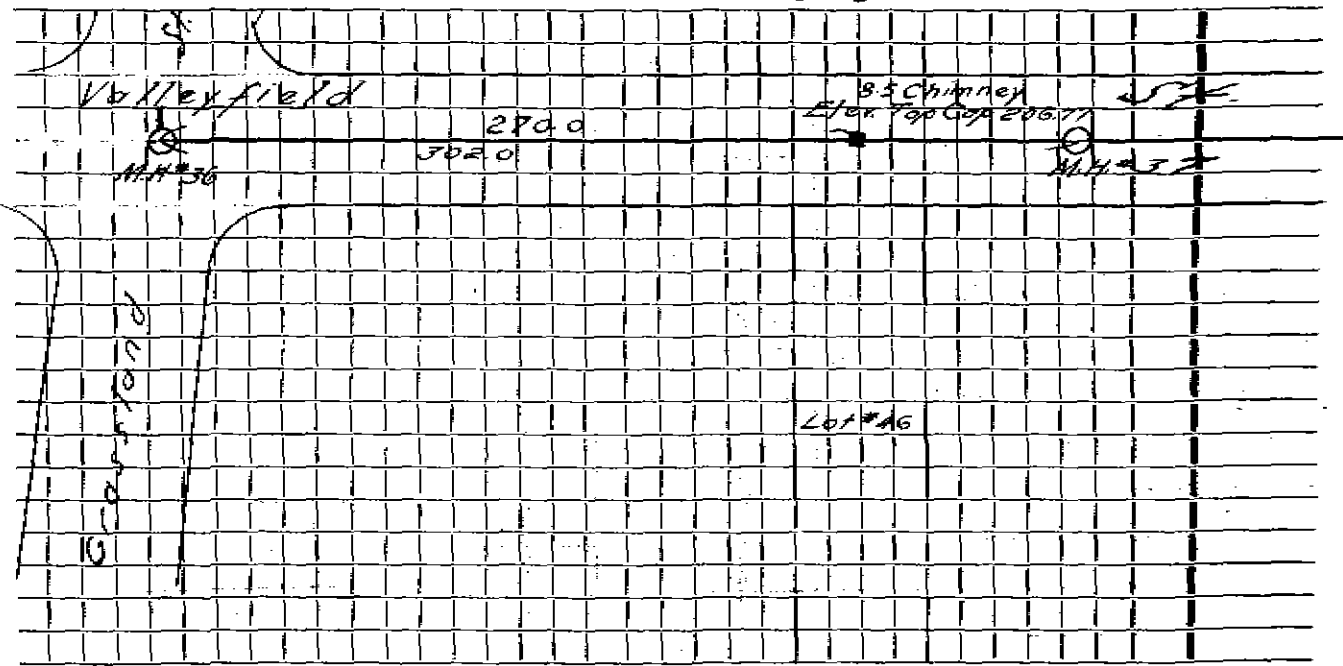

Connection made in Street. Work completed

Remarks:
.....
.....