


DATE 1/9/94

TOWN OF LEXINGTON — BOARD OF PUBLIC WORKS
SEWER DIVISION

Sketch of Service Here **70**

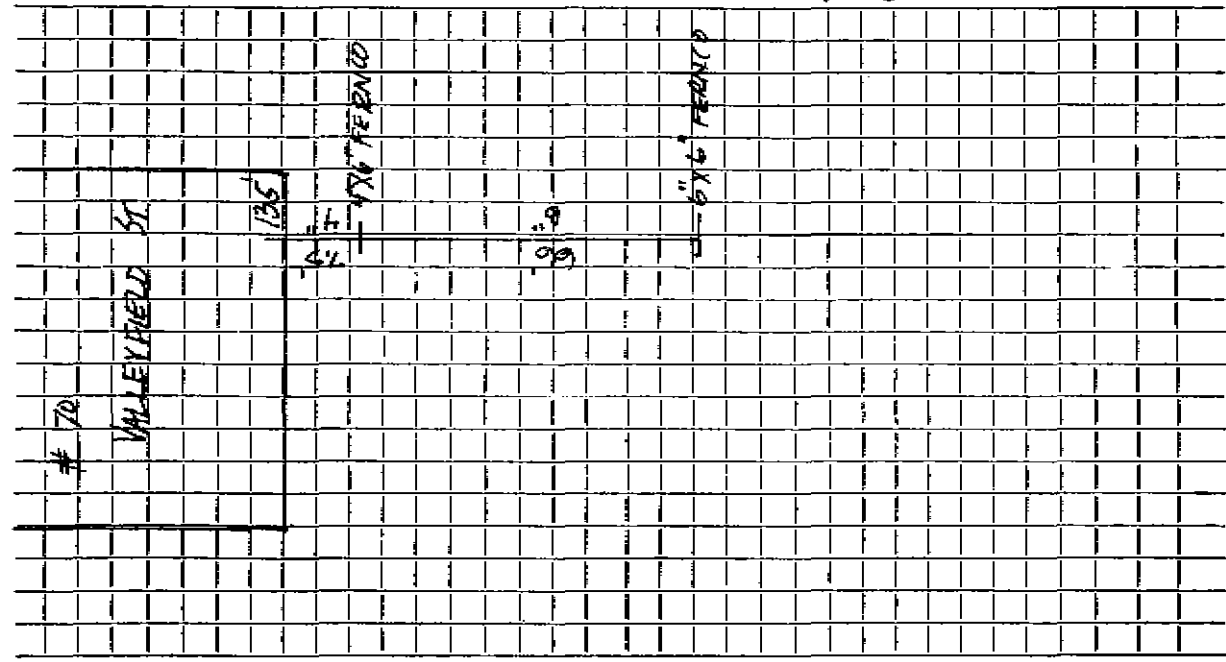

Connection made in Street. Work completed 10/17/23 G.B.F......

Remarks:
.....
.....