




DATE 11-14-90

TOWN OF LEXINGTON — BOARD OF PUBLIC WORKS

SEWER DIVISION

#73 VALLEYFIELD Rd.

Sketch of Service Here **73**

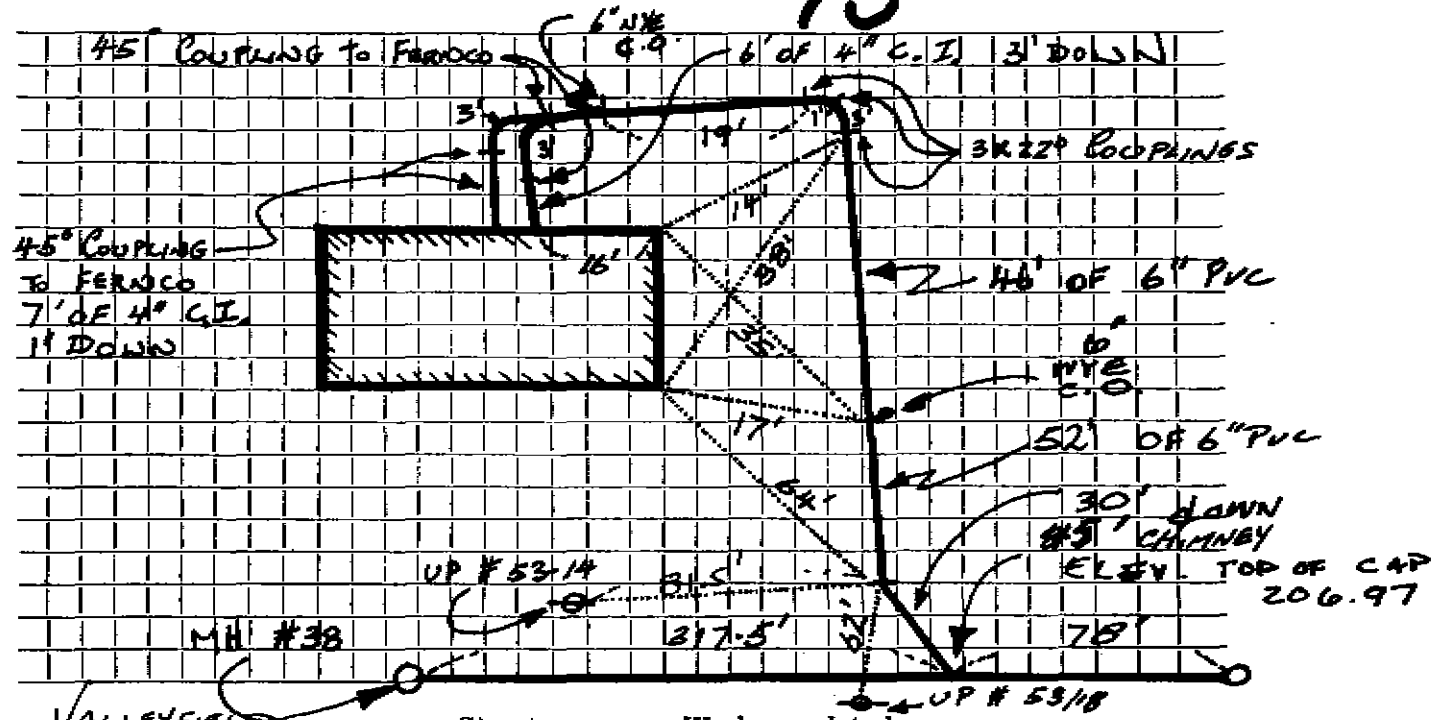

Connection made in Valleyfield Street. Work completed

Remarks: INSPECTED 11-14-90 BY P. BARRONS INSTALLED BY SUBURBANITE CONST.