

Name **Volunteer Assoc. Realty Trust**

Service No. **53**

Address **74 Valleyfield Street**

11' 4 3/4 ft

Lot #83 74 Valleyfield ST.

Location

Kind of Pipe

Size **6"**

Size of Main **24"**

Repair—Renewal—New Service

W.O. #5532

Location **AUG 5 1968**

Lexington Sewerage #1111

Date		Material	Amount		Total	Date	Amount	
5-68	21'	6" Transite pipe				7-15-68		140 11
	10'	4" Cast Iron pipe						
3/67		Labor	52	12				
4/67		"	19	55				
		10% O.H.	7	17	78 84			
	30'	6" transite pipe @ .88			26 40			
	1	Cap			1 63			
	1/2	Ton Stone @ 1.65			41			
	1/2	Bag Cement @ 1.55			33			
	3	Hrs. Shovel @ 6.50			19 50			
	3	Hrs. Trucking @ 3.00			9 00			
	1	Hr. Loader			4 00			
					140 11			


DATE _____

TOWN OF LEXINGTON — BOARD OF PUBLIC WORKS

SEWER DIVISION

Sketch of Service Here

74

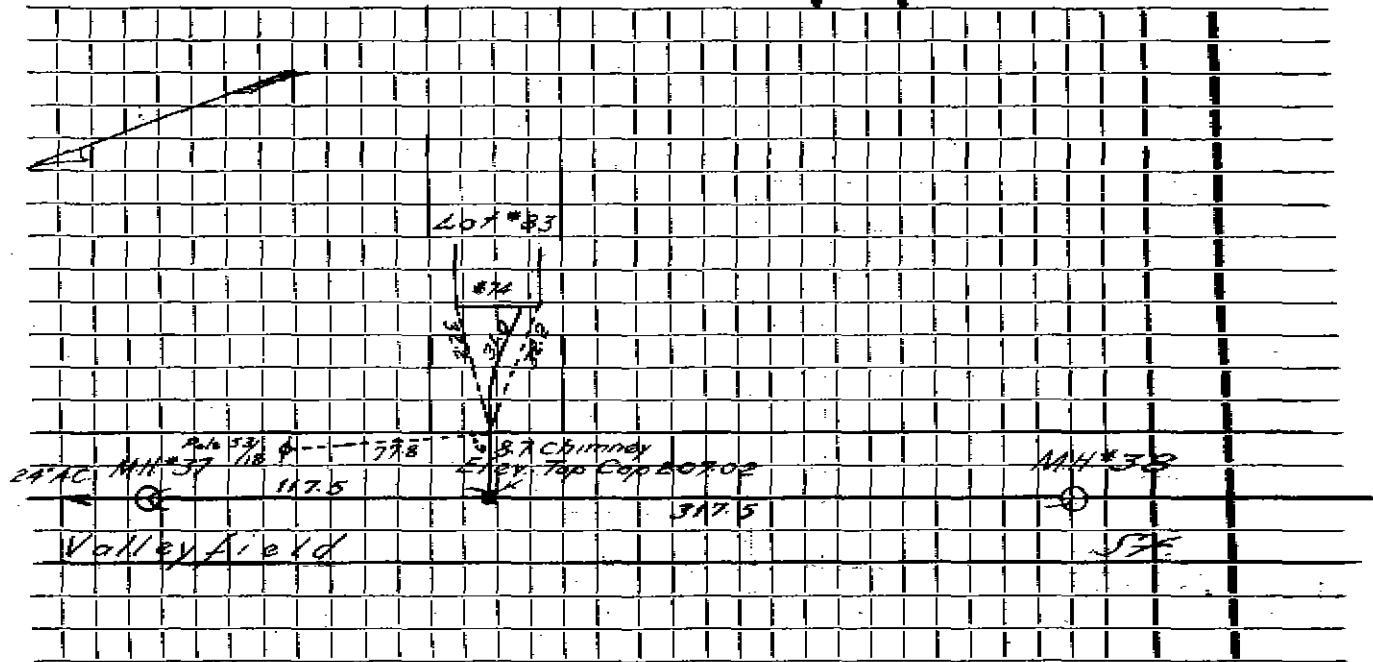

Connection made in Street. Work completed

Remarks:

.....

.....