

Name **Volunteer Assoc Realty Trust**

Service No. **54**

Address **76 Valleyfield Street**

11+98 Left **Lot #82 76 Valleyfield ST.** Location

Kind of Pipe

Size **6"**

Size of Main **24"**

Repair—Renewal—New Service **W.O. #5533 Lexington Sewerage #1112**

Location **AUG 5 1968**

Date	Material	Amount	Total	Date	Amount
5-68	16' 6" Transite pipe			7-15-68	90.36
	10' 4" Cast Iron pipe				
12/67	Labor	39 09			
	10% O.H.	3 91	43 00		
	30' 6" transite pipe @ .88		26 40		
	1 Cap		1 63		
	1/2 Bag Cement @ 1.55		33		
	2 Hrs. Shovel @ 6.50		13 00		
	2 Hrs. Trucking @ 3.00		6 00		
			90 36		

Deposit


90.36

DATE _____

TOWN OF LEXINGTON — BOARD OF PUBLIC WORKS

SEWER DIVISION

Sketch of Service Here **76**

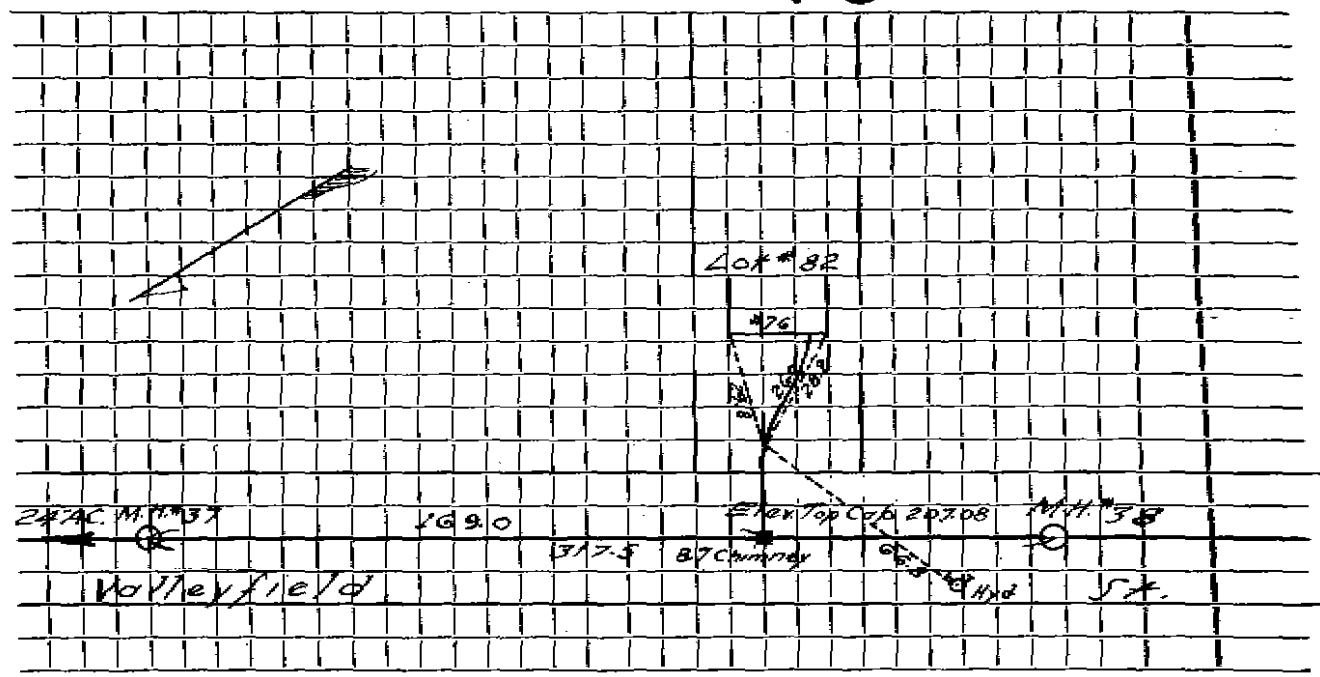

Connection made in Street. Work completed

Remarks:
.....
.....