




DATE \_\_\_\_\_

TOWN OF LEXINGTON — BOARD OF PUBLIC WORKS

SEWER DIVISION

Sketch of Service Here

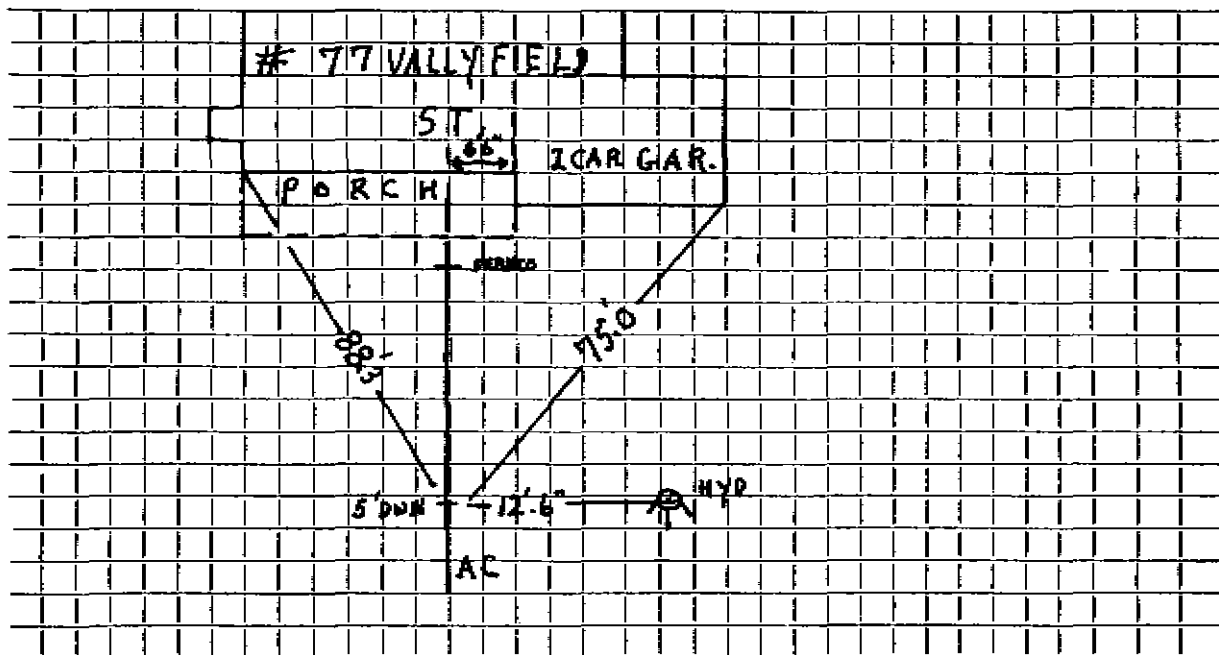

Connection made in ..... Street. Work completed .....

Remarks: .....  
.....  
.....

Name

Service No.

Address 77 Valleyfield Street

a. 12+48 right Lot #51 77 Valleyfield Street Location

Kind of Pipe

Size 6"

Size of Main 24"

Repair—Renewal—New Service W.O. #5535

Location


Date	Material	Amount	Total	Date	Amount
10/2/67	Labor	39 09			
	10% O.H.	3 91	43 00		
	20' 6" transite pipe @ .88		17 60		
	1/4 Bag Cement @ 1.55		33		
	5 Ton 3/4" stone @ 1.65		28 25		
	2 Hrs. Shovel @ 6.50		13 00		
	2 Hrs. Trucking @ 3.00		6 00		
			88 18		

DATE \_\_\_\_\_

TOWN OF LEXINGTON — BOARD OF PUBLIC WORKS  
SEWER DIVISION

Sketch of Service Here

77

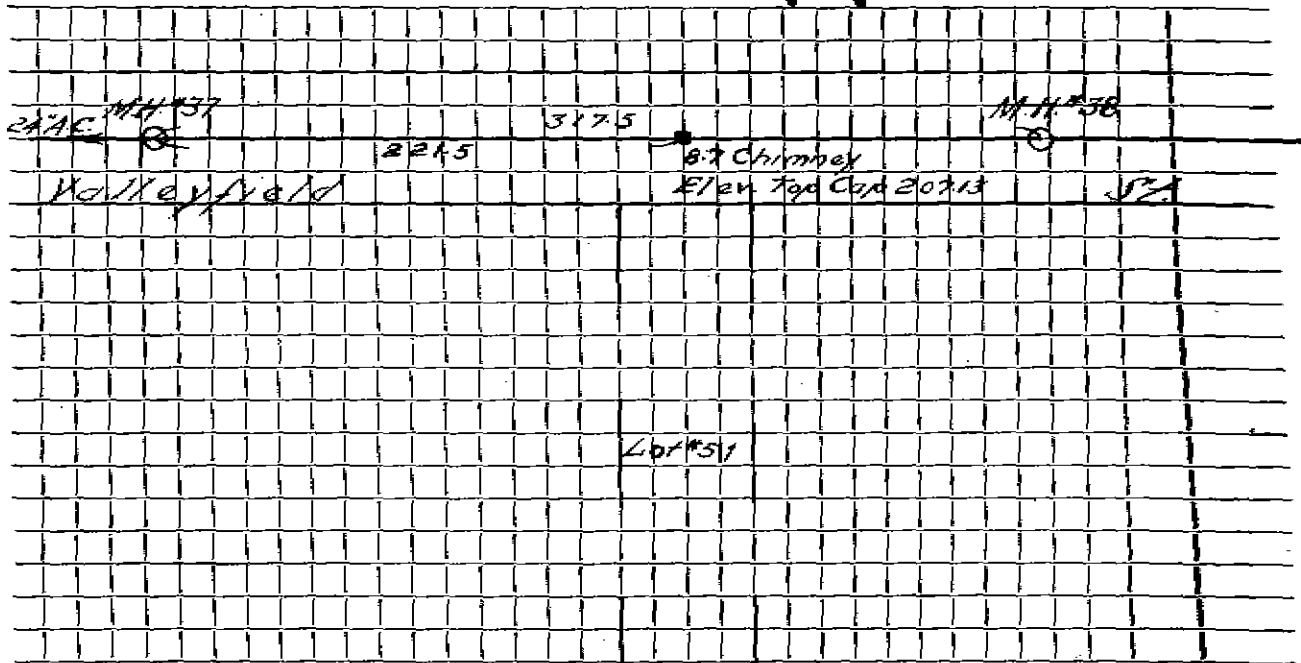

Connection made in ..... Street. Work completed .....

Remarks: .....

.....

.....