

Name **Volunteer Assoc Realty Trust**

Service No. **55**

Address **78 Valleyfield Street**

12-48 Left Lot #81 78 Valleyfield Street Location

Kind of Pipe

Size **6"**

Size of Main **24"**

Repair—Renewal—New Service W.O. #5534 Lexington Sewerage #1113

Location **AUG 5 1968**


Date		Material	Amount	Total	Date	Amount
16-68	24'	6" Transite pipe			7-15-68	Deposit 118 60
	10'	4" Cast Iron pipe				
2/67		Labor	26.06			
3/67		"	32.58	58 64		
		10% O.H.) 5 86	64 50		
	30'	6" transite pipe @ .88		26 40		
	1	Cap		1 63		
	1/2	Ton 3/4" stone @ 1.65		82		
	2 1/2	Hrs. Shovel @ 6.50		16 25		
	3	Hrs. Trucking @ 3.00		9 00		
				118 60		
6-68	24'	6" Transite pipe				
	10'	4" Cast Iron pipe				

DATE _____

TOWN OF LEXINGTON — BOARD OF PUBLIC WORKS

SEWER DIVISION

Sketch of Service Here **78**

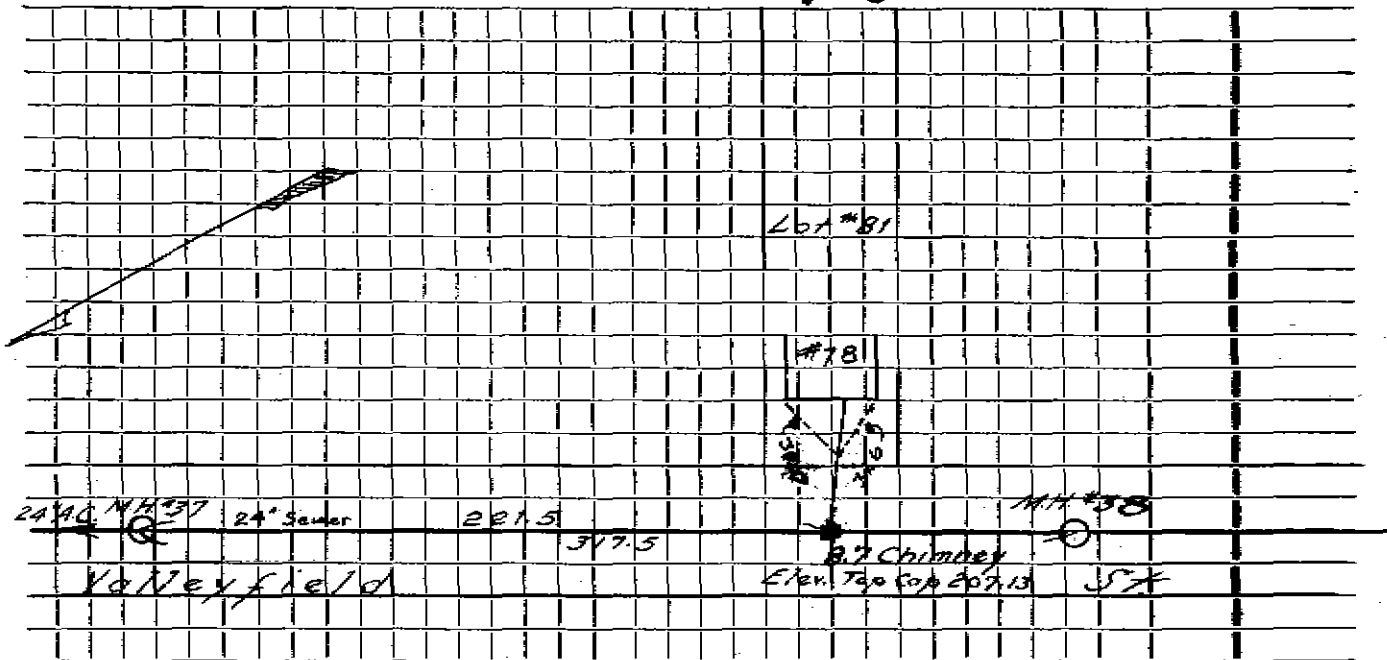

Connection made in Street. Work completed

Remarks:
.....
.....