

二三

Name Address No. 96 Wallerfield Street

Address 96 Wallerfield Street

Lott. #72 96 Valleyfield Street Location

Kind of Pipe	Size 6"	Size 6"	Size of Main 24"
--------------	---------	---------	------------------

Repair—Removal—New Service

DATE _____


TOWN OF LEXINGTON — BOARD OF PUBLIC WORKS

SEWER DIVISION

Sketch of Service Here

96

Lot # 82

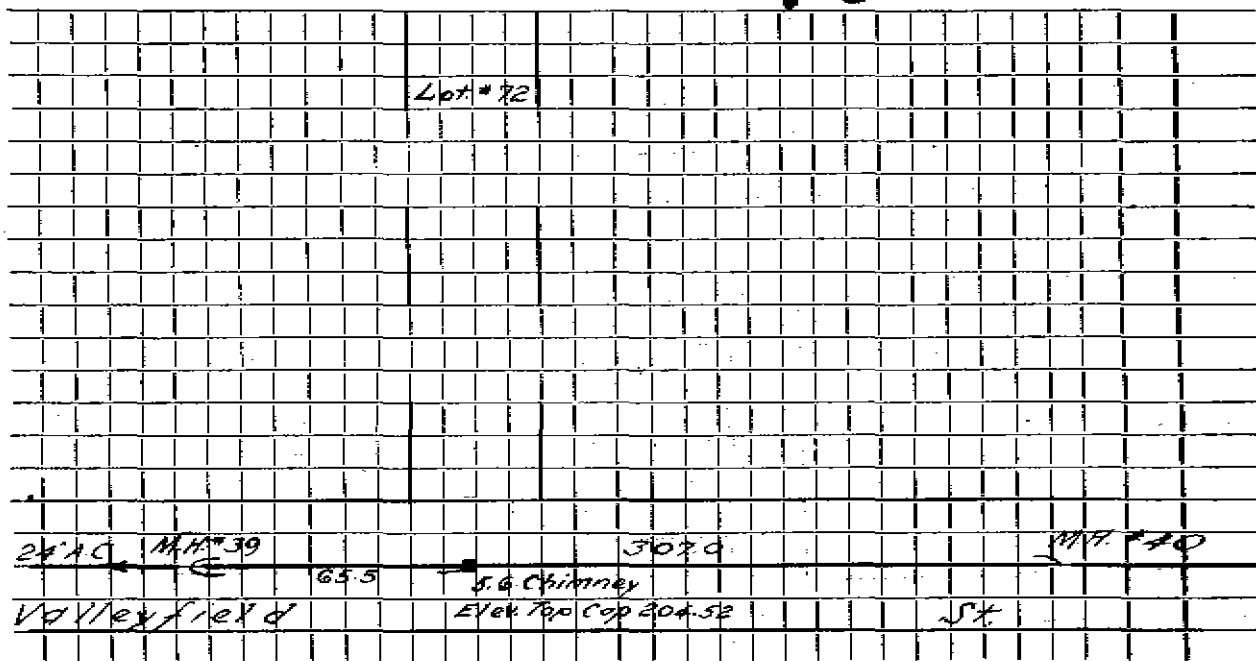

Connection made in Street. Work completed

Remarks: