

Name

Service No.

Address 97 Valleyfield Street

Lot #61 97 Valleyfield Street Location

Kind of Pipe

Size 6"

Size of Main 24"

Repair—Renewal—New Service

Location


Date	Material	Amount	Total	Date	Amount

DATE \_\_\_\_\_

TOWN OF LEXINGTON — BOARD OF PUBLIC WORKS

SEWER DIVISION

Sketch of Service Here **97**

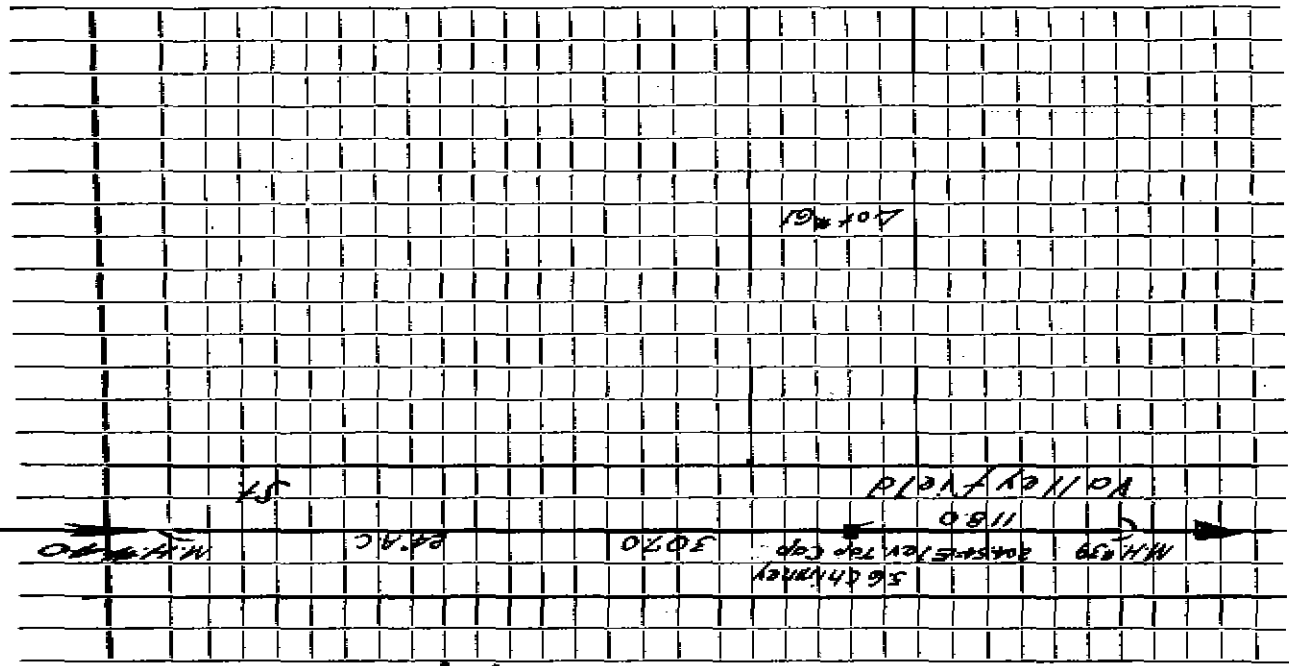

Connection made in \_\_\_\_\_ Street. Work completed \_\_\_\_\_

Remarks: \_\_\_\_\_