

Service No.

Name

Address 98 Valleyfield Street

Lot #71 98 Valleyfield Street Location

Kind of Pipe

Size 6"

Size of Main 24"

Repair—Renewal—New Service


Location

Date	Material	Amount	Total	Date	Amount

DATE \_\_\_\_\_

TOWN OF LEXINGTON — BOARD OF PUBLIC WORKS  
SEWER DIVISION

Sketch of Service Here **98**

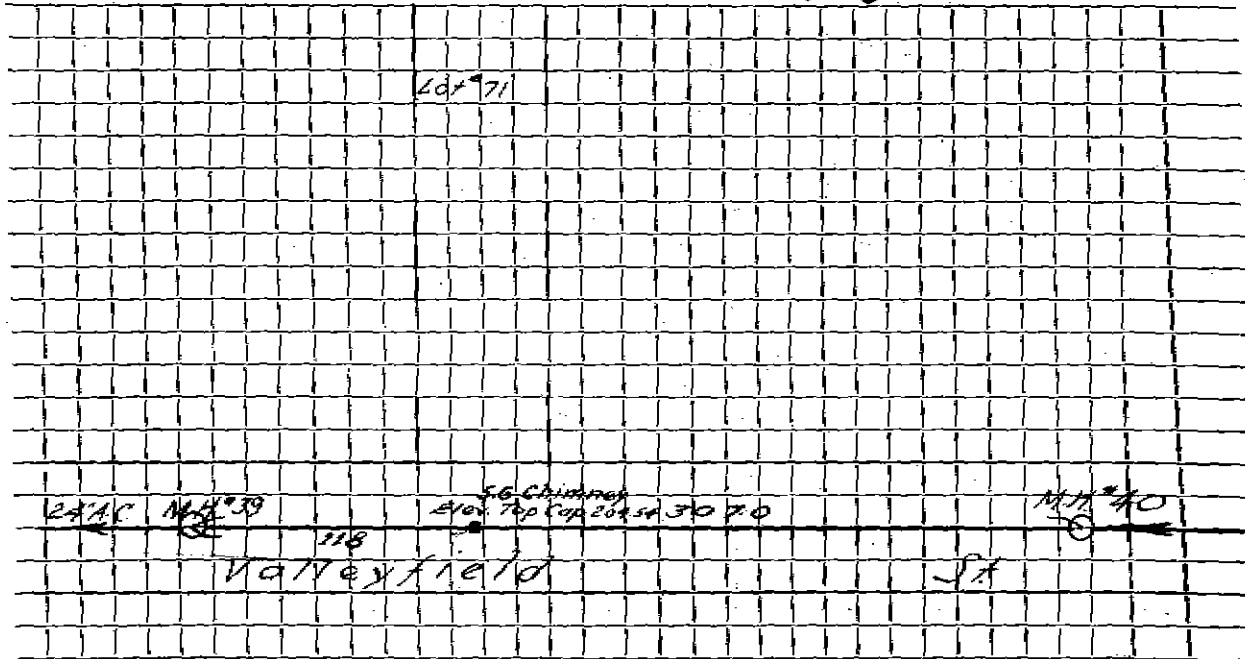

Connection made in ..... Street. Work completed .....

Remarks: .....  
.....  
.....