


9 JOHN POULTER
RD 40-209

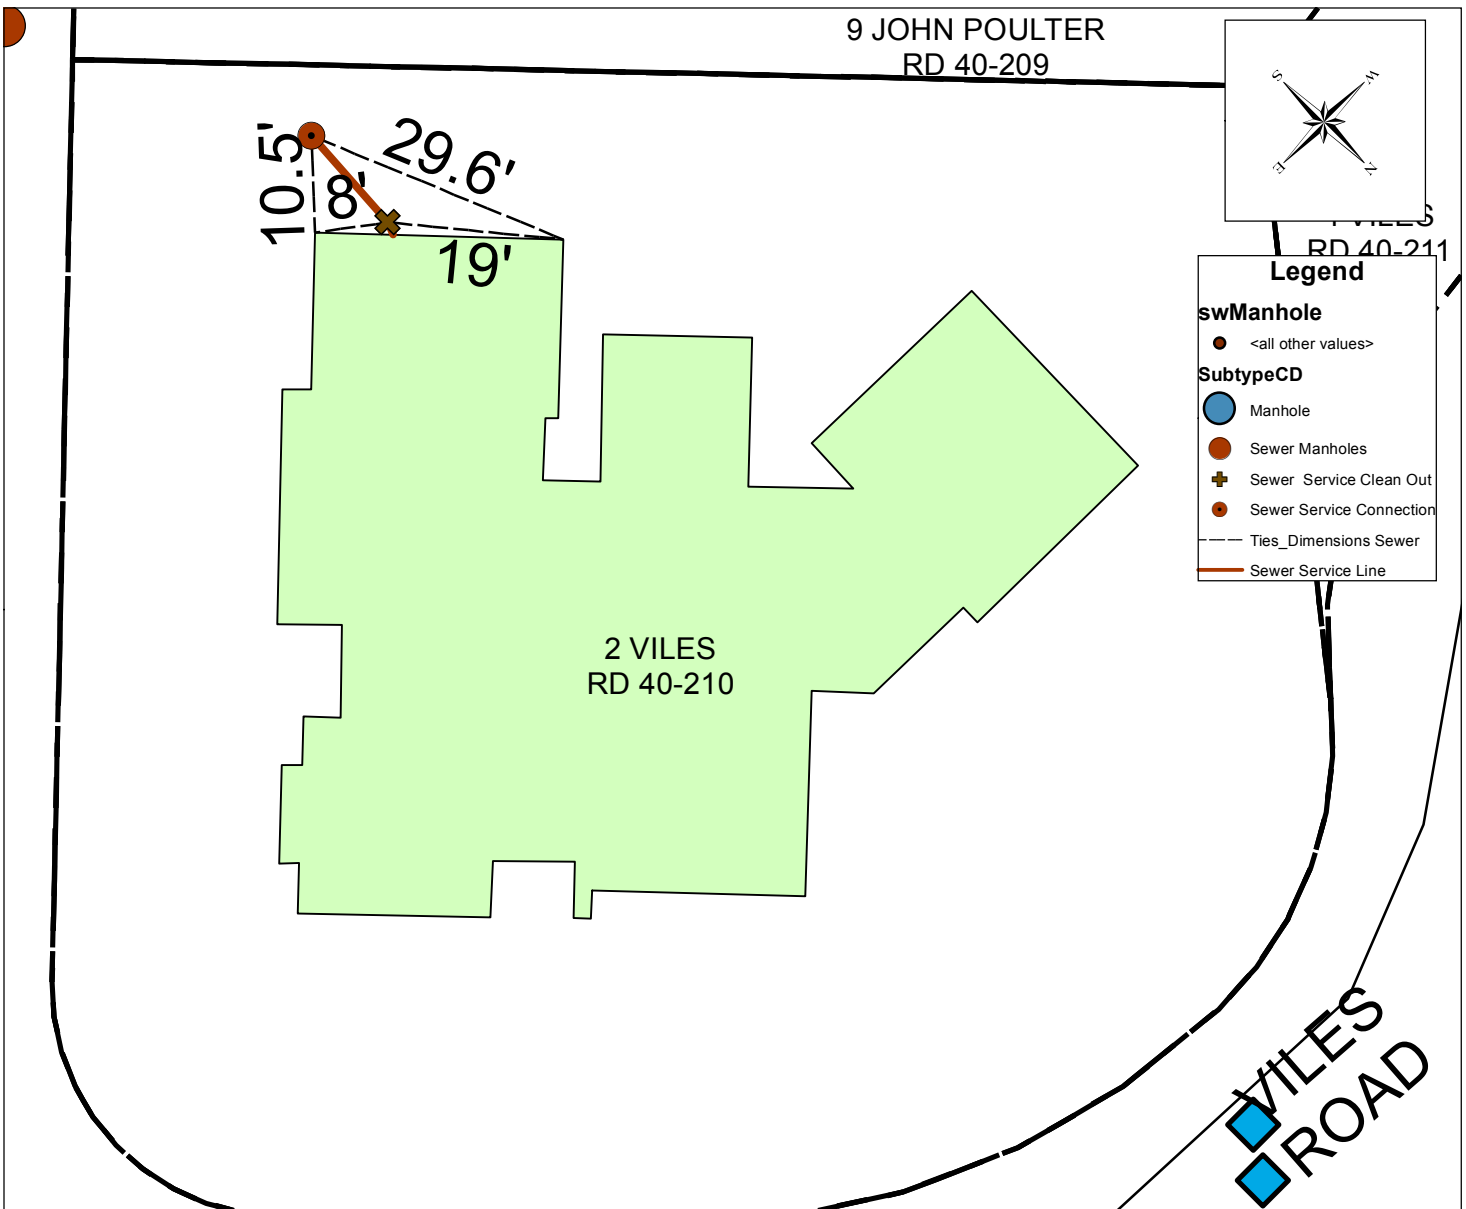

Address	Map and Lot	Permit Number	Contractor Name	Inspector
2 Viles Rd	40-210	6208	McLaughlin, James M. Inc.	msprague
Date	Material	Depth of Cover	Amount	
6/16/2015	6x6 PVC to PVC Fern Co	9 ft	1-Connect to existing wye	
	6" PVC Pipe - SDR 35		7.5 ft	
	6" PVC Clean out		1	
Type of work completed				

New 6" PVC sewer service installed to new house, connection to existing stub.