

Name R. J. Foley

Service No. 174 <sup>74</sup>

Address 3 Viles Road

Lot 4 Sta. 1+59 Elev. 198.15 Location

Kind of Pipe Size 6"

Size of Main 8"

Repair—Renewal—New Service DeFlice Brothers # 514


Location *Ann 58 47*

Date	Material	Amount	Total	Date	Amount
8-10-62	20' 6" Transite pipe @.82 BILL WHEN CONNECTED		16.40	<i>12-22-64</i>	<i>16 40</i>
10/67	42' 6" Transite				
	10' 4" Cast Iron				

TOWN OF LEXINGTON — BOARD OF PUBLIC WORKS

SEWER DIVISION

Sketch of Service Here **3**

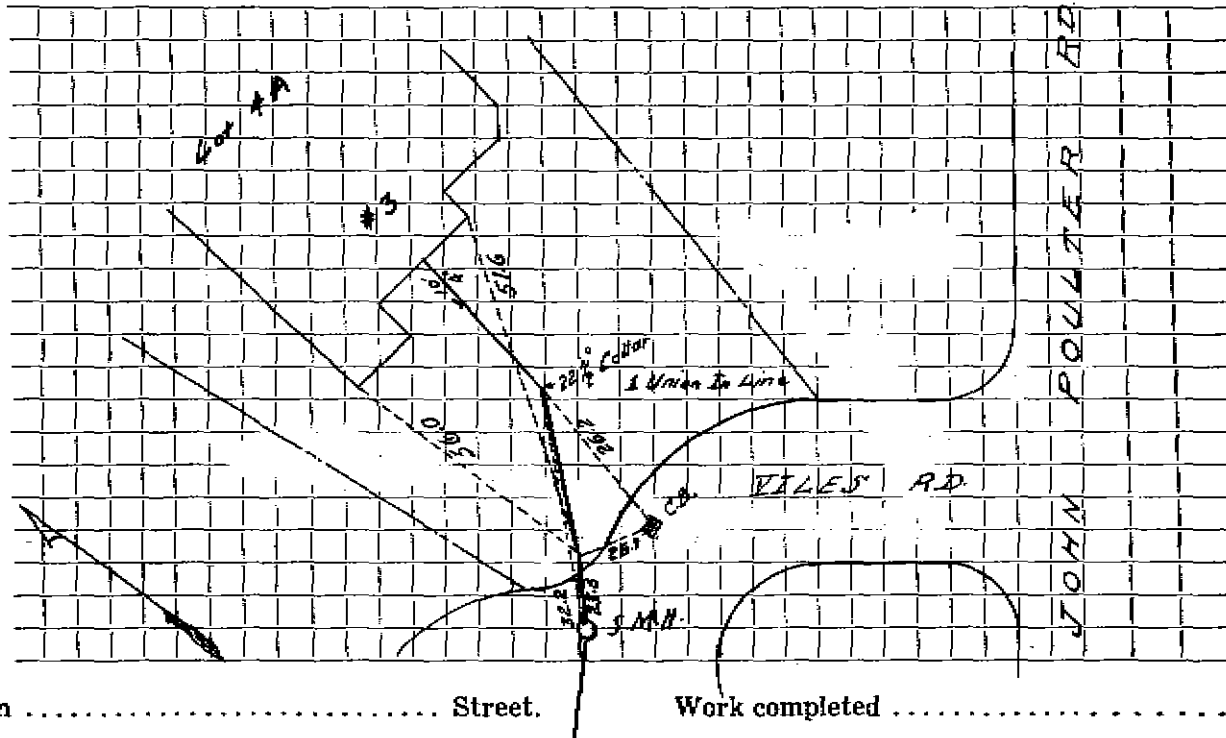

Connection made in ..... Street. Work completed .....

Remarks: .....  
.....  
.....