

Name **Foley Realty Trust**

Service No.

Address **4 Viles Road**

Lot 2 Sta. 2+78

Location

Kind of Pipe

Size **6"**

Size of Main **8"**

~~Main Material~~ — **New Service DeFlice Bros. - Permit #98**

Location

Date	Material	Amount	Total	Date	Amount
0-2-64	35' 6" Transite pipe				


[Signature]

DATE _____

TOWN OF LEXINGTON — BOARD OF PUBLIC WORKS

SEWER DIVISION

Sketch of Service Here **4**

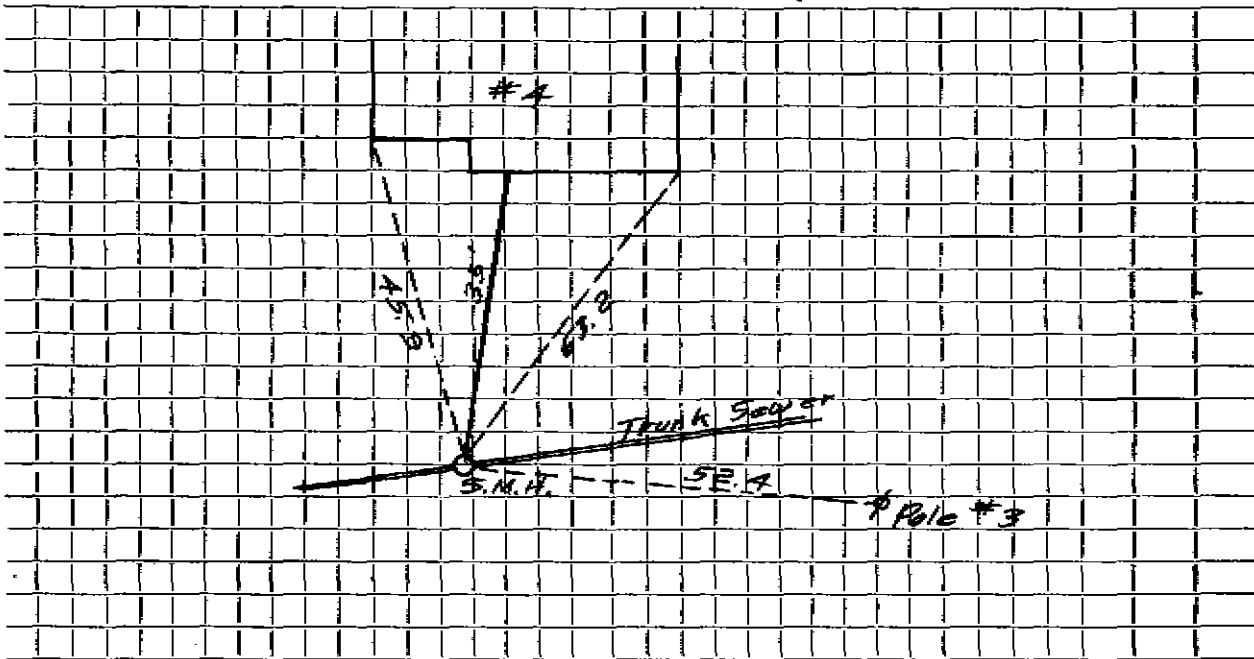

Connection made in Street. Work completed

Remarks:
.....
.....