

Name

Service No.

Address 1 Village Circle

Lot #1 1 Village Circle

Location

Kind of Pipe

Size 6"

Size of Main 10"

Repair—Renewal—New Service Lucente
Lucente #1728

Location


Date		Material	Amount		Total		Date		Amount	
10-5-70	35'	6" Transite pipe								
2/10/70	35'	6" Transite pipe								
	10'	4" Cast Iron								

DATE _____

TOWN OF LEXINGTON — BOARD OF PUBLIC WORKS

SEWER DIVISION

Sketch of Service Here /

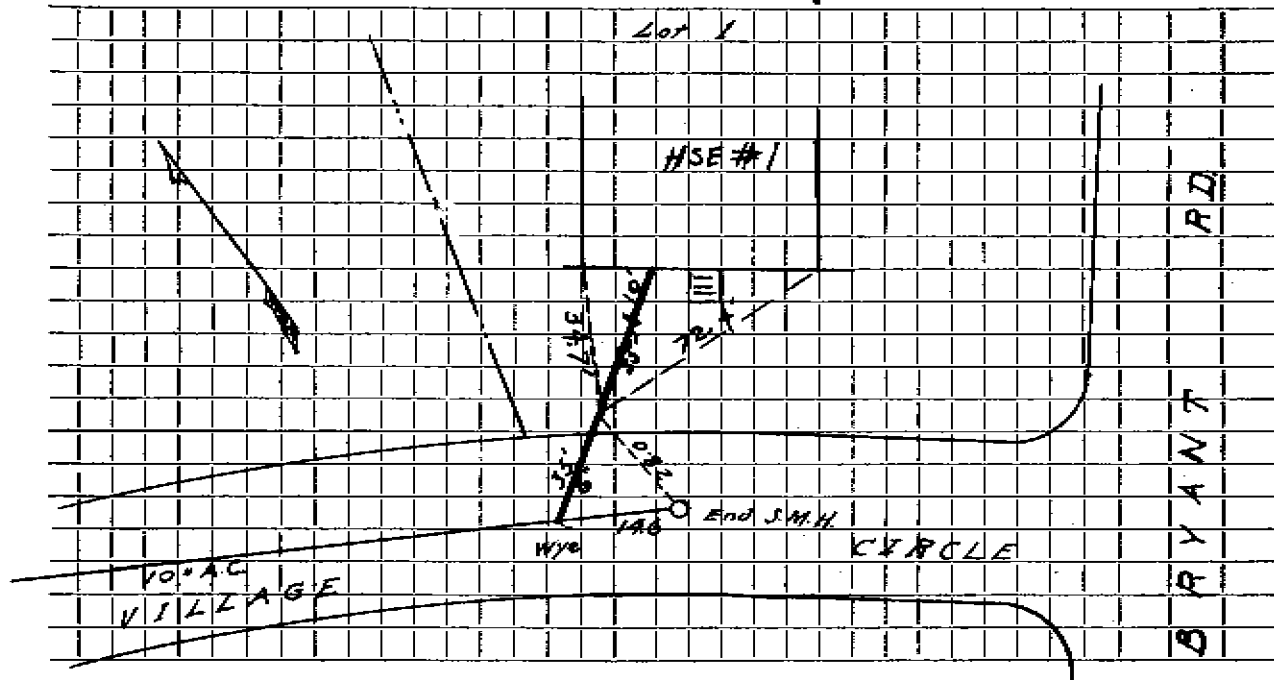

Connection made in Street. Work completed

Remarks:

.....

.....