

Name **Louis Stocio**

Service No.

Address **14 Village Circle**

Lot #11 14 Village Circle

Location

Kind of Pipe

Size **6"**

Size of Main **10"**

Repair—Renewal—New Service

Lucente #2133

Location

Date	Material	Amount	Total	Date	Amount
-5-70 115 1/2'	6" Transite pipe				
/31/72 48'	6" Transite pipe				
10'	4" Cast Iron pipe				



DATE _____

TOWN OF LEXINGTON — BOARD OF PUBLIC WORKS

SEWER DIVISION

Sketch of Service Here

14

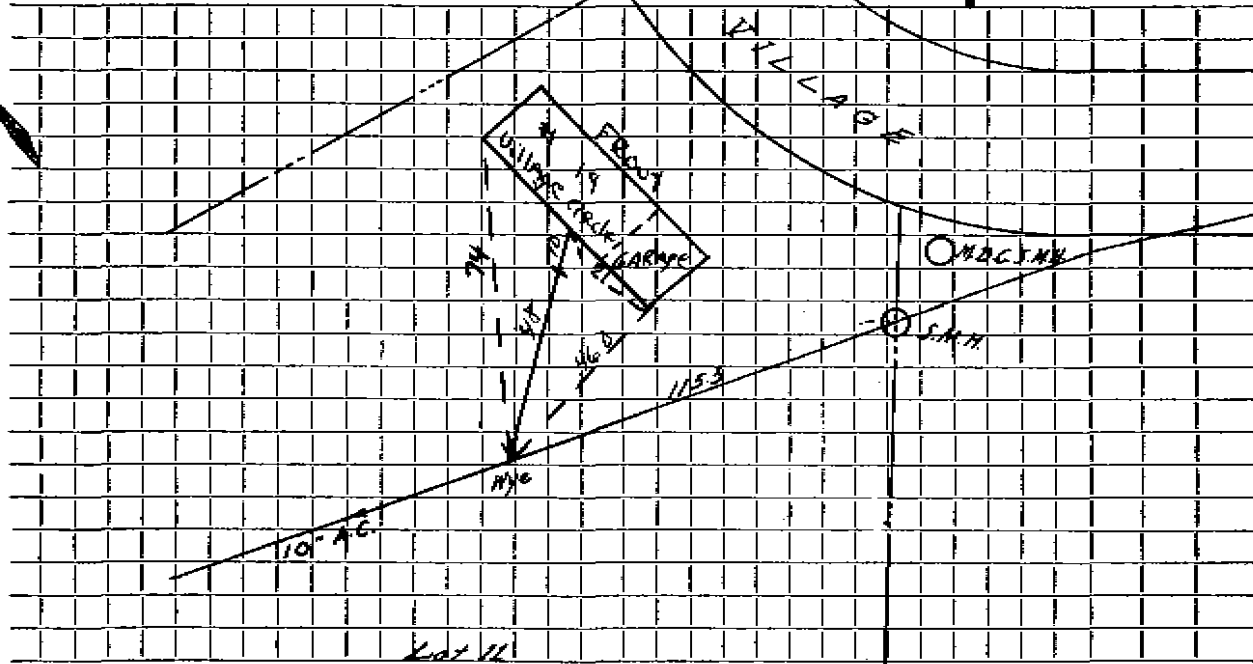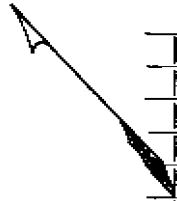

Connection made in Street. Work completed

Remarks:

.....

.....