

Name Village Development Corp.

Service No.

Address 16 Village Circle

Lot #12 16 Village Circle Location

Kind of Pipe Size 6"

Size of Main 10"

Repair—Renewal—New Service Lucente # 1972  
Lucente #1739

Location


| Date            | Material              | Amount | Total | Date | Amount |
|-----------------|-----------------------|--------|-------|------|--------|
| <del>6-70</del> | 100' 6" Transite pipe |        |       |      |        |
| 12/2/71         | 25' 6" Transite pipe  |        |       |      |        |
|                 | 10' 4" Cast Iron      |        |       |      |        |
|                 |                       |        |       |      |        |
|                 |                       |        |       |      |        |
DATE \_\_\_\_\_

TOWN OF LEXINGTON — BOARD OF PUBLIC WORKS

SEWER DIVISION

Sketch of Service Here **16**

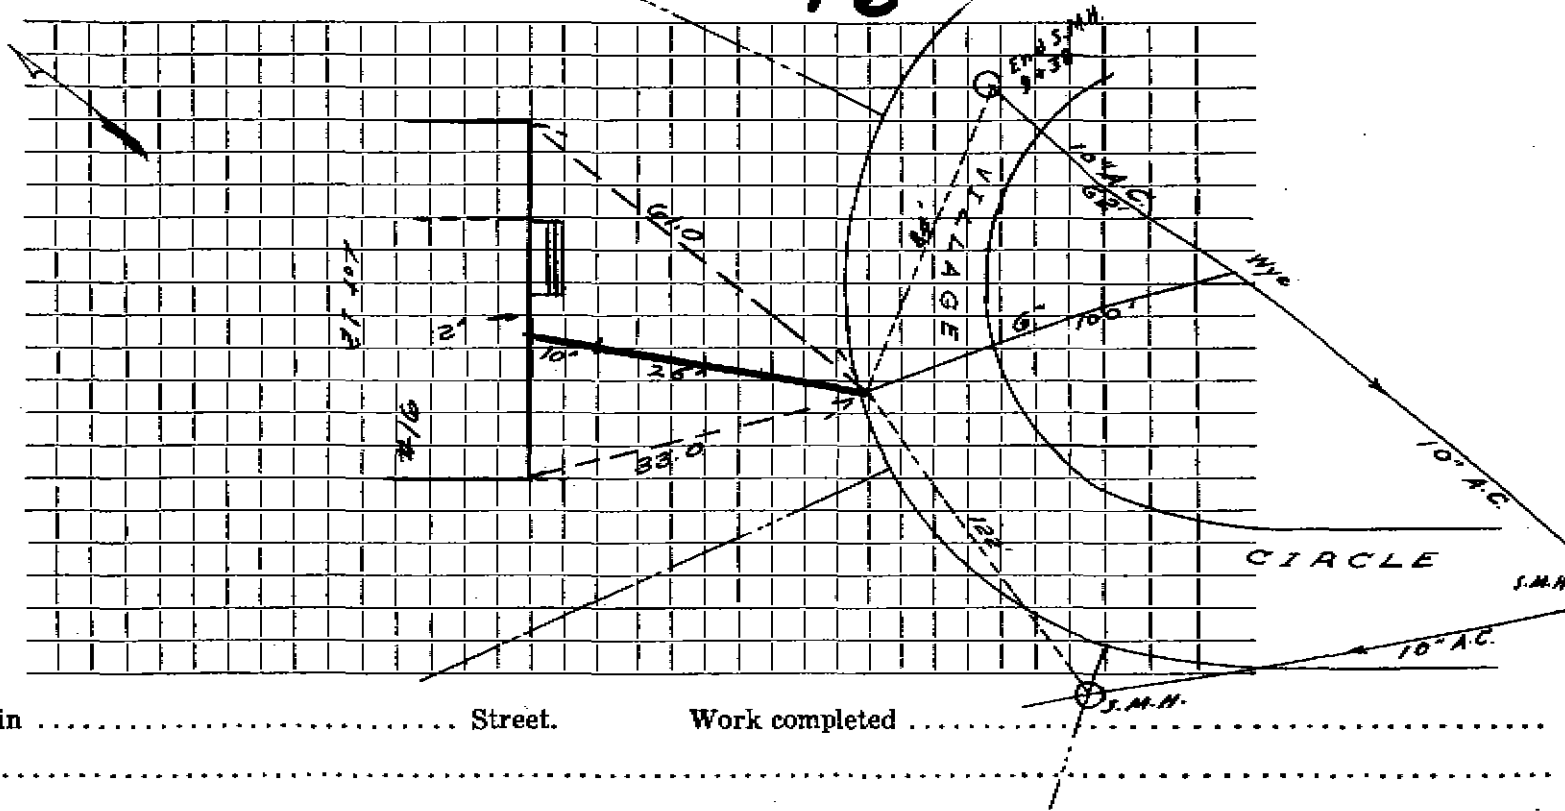

Connection made in ..... Street. Work completed .....

Remarks: .....

.....

.....