

**Name**

Village Development

**Service No.****Address**

20 Village Circle

Lot #14 20 Village Circle Location

**Kind of Pipe**

Size 6"

Size of Main 10"

**Repair—Renewal—New Service**

Lucente # 1973

Lucente #1741

Location


Date		Material	Amount	Total	Date		Amount
0-6-70	120'	6" Transite pipe					
12/2/72	25'	6" Transite pipe					
	10'	4" Cast Iron					

DATE \_\_\_\_\_

TOWN OF LEXINGTON — BOARD OF PUBLIC WORKS  
SEWER DIVISION

Sketch of Service Here

20

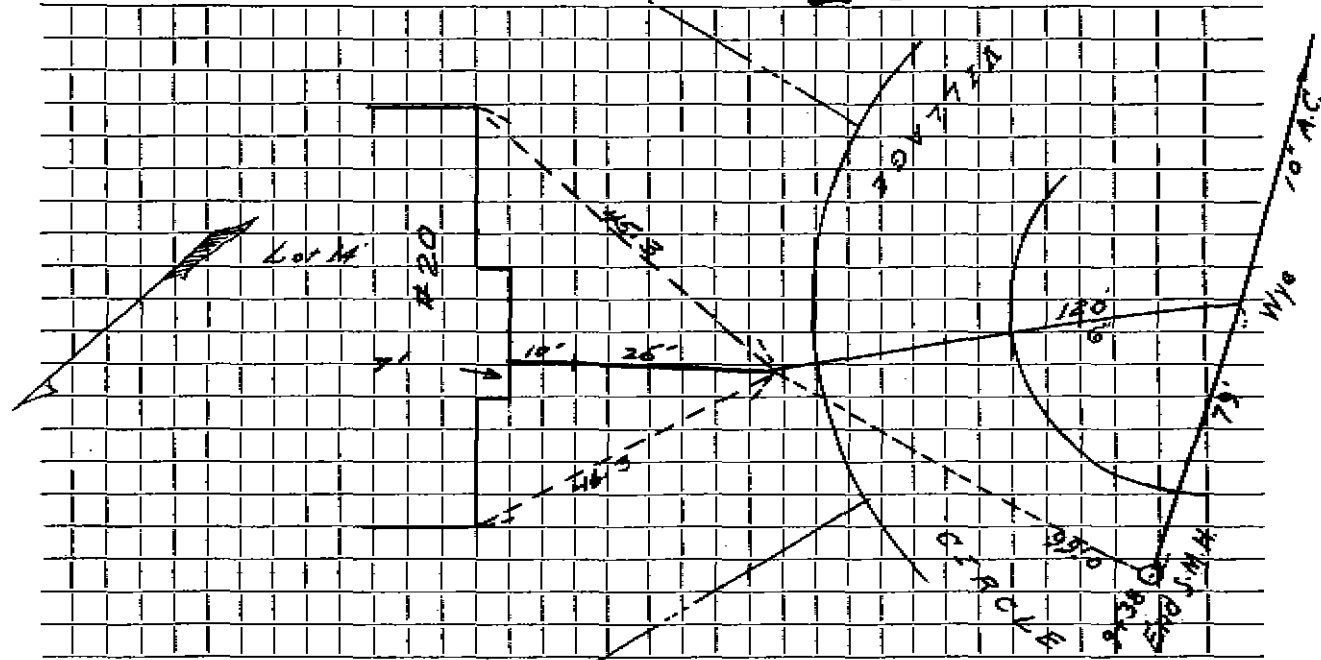

Connection made in ..... Street. Work completed .....

Remarks: .....

.....

.....