




DATE \_\_\_\_\_

TOWN OF LEXINGTON — BOARD OF PUBLIC WORKS

SEWER DIVISION

22 Sketch of Service Here

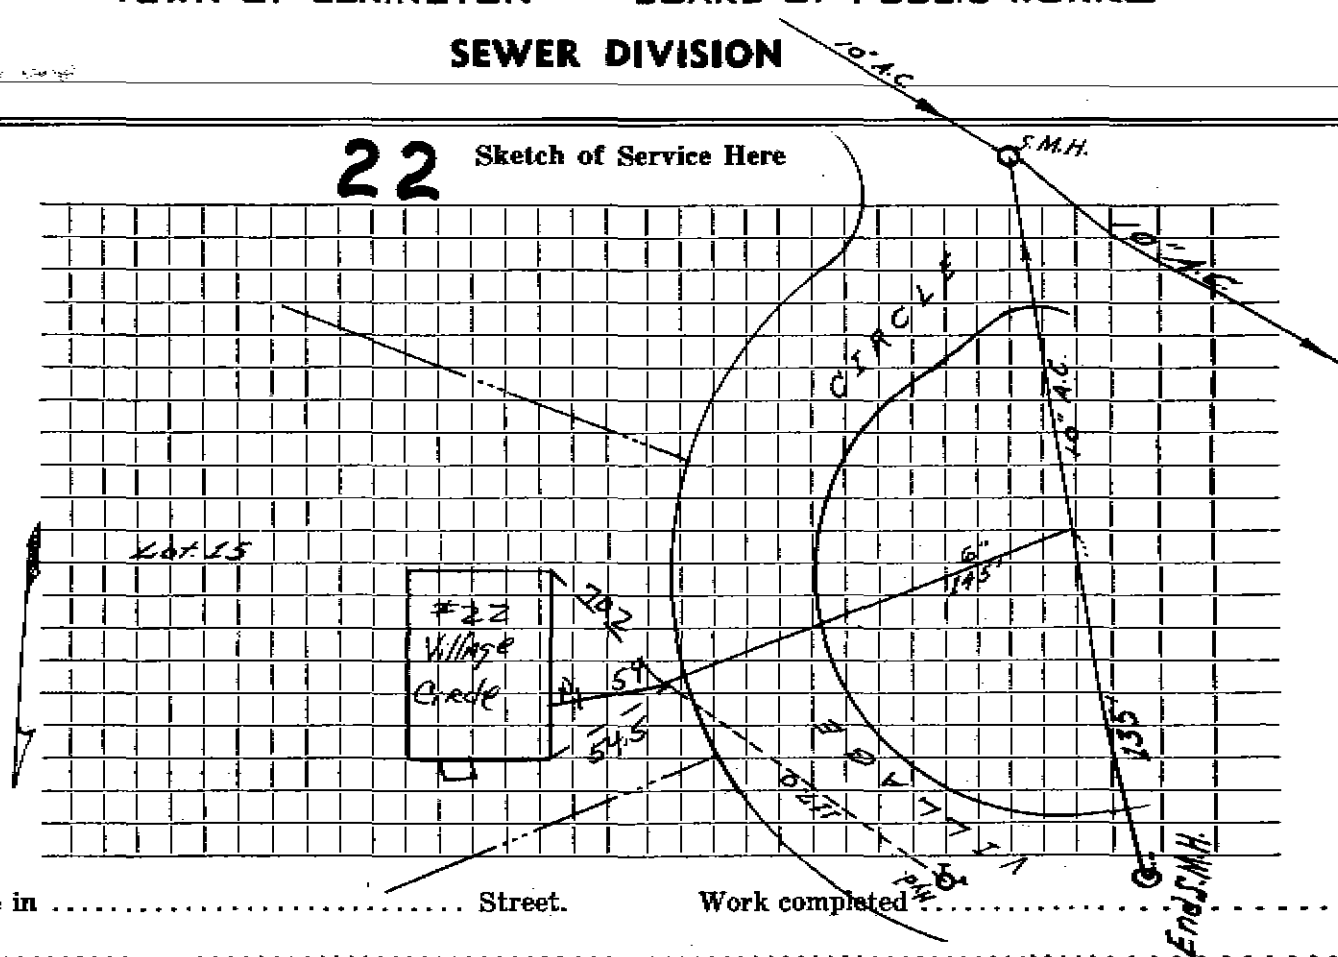

Connection made in ..... Street. Work completed

Remarks: .....

.....

.....