

Name Louis Stoico

Service No.

Address 6 Village Circle

Lot #6 6 Village Circle

Location

Kind of Pipe

Size 6"

Size of Main 10"

~~REPAIR/REPLACE~~ New Service Lucente # ~~1999~~ 2319

Location

Date		Material	Amount	Total	Date	Amount
0-19-70	35'	6" Transite pipe				
5-21-73	10'	4" Cast Iron pipe				
	23'	6" Transite pipe				


DATE _____

TOWN OF LEXINGTON — BOARD OF PUBLIC WORKS

SEWER DIVISION

Sketch of Service Here

6

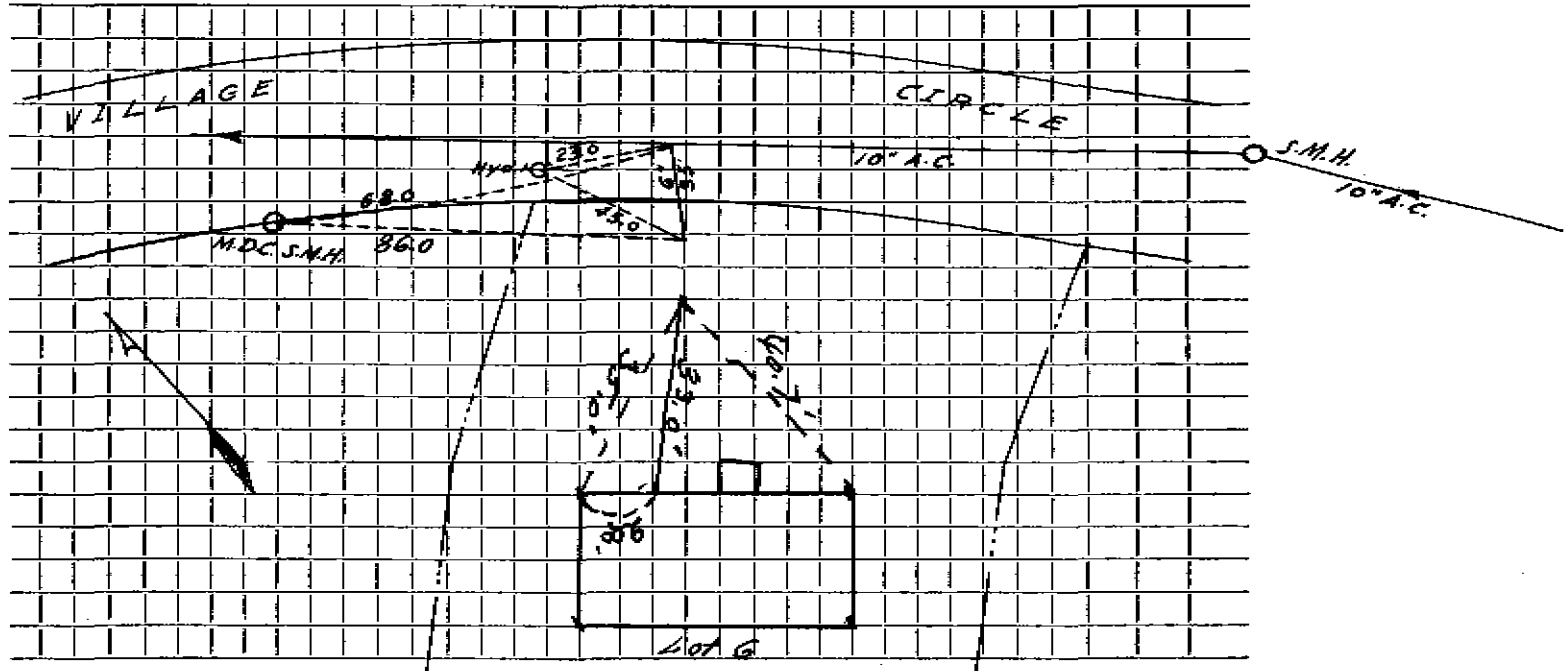

Connection made in Street. Work completed

Remarks:

.....

.....