

Name Louis Stoccio

Service No.

Address 9 Village Circle

Lot #7 9 Village Circle

Location

Kind of Pipe

Size 6"

Size of Main 10"

Repair—Renewal—New Service

Lucente #2331  
Lucente #1734

Location


Date		Material	Amount	Total	Date	Amount
-6-70	40'	6" Transite pipe				
1/13/73	24'	6" Transite pipe				
	10'	4" Cast Iron pipe				

DATE \_\_\_\_\_

TOWN OF LEXINGTON — BOARD OF PUBLIC WORKS  
SEWER DIVISION

Sketch of Service Here

9

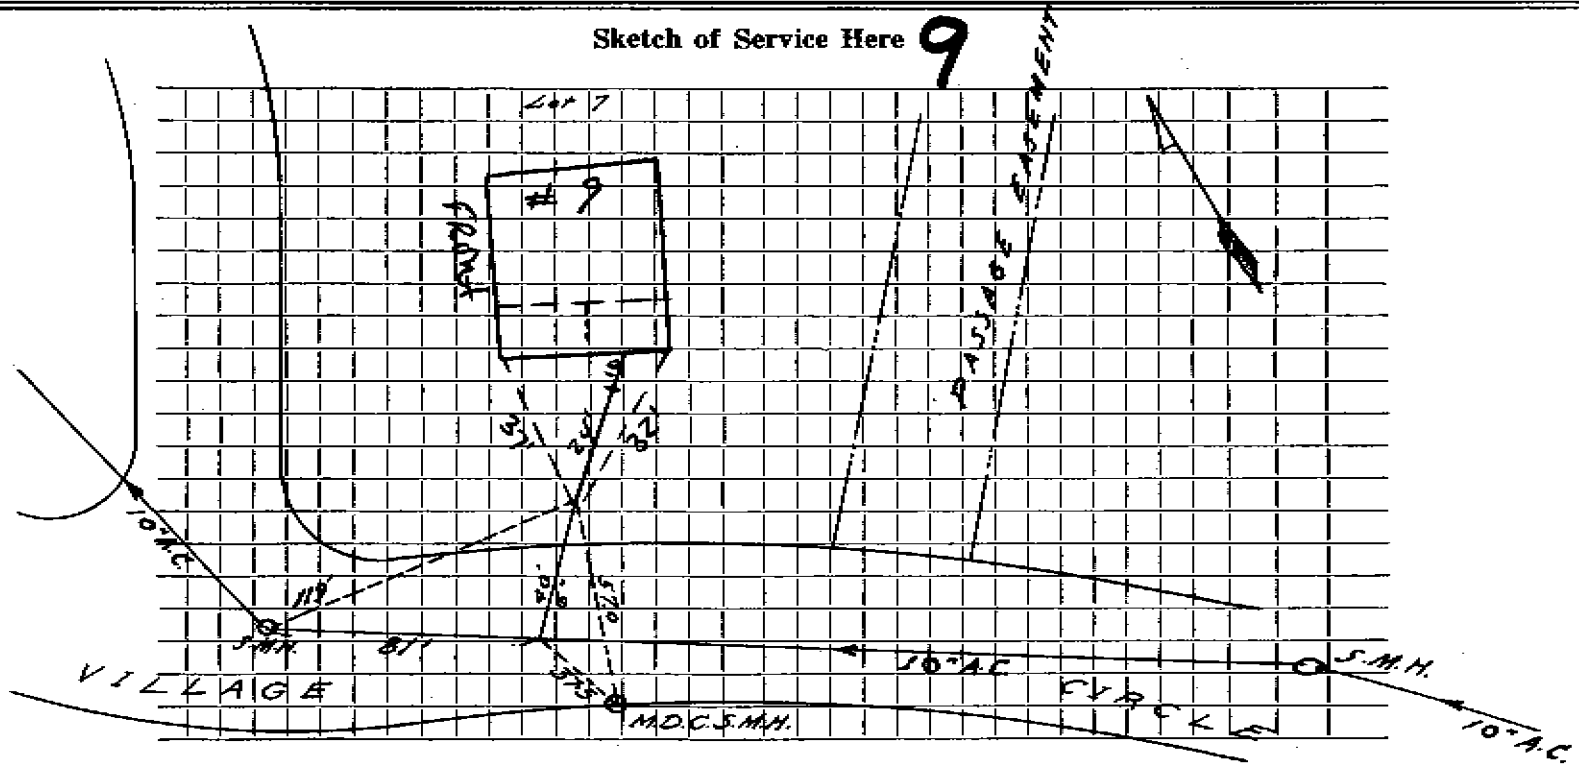

Connection made in ..... Street. Work completed .....

Remarks: .....  
.....  
.....