




DATE \_\_\_\_\_

TOWN OF LEXINGTON — BOARD OF PUBLIC WORKS  
SEWER DIVISION

Sketch of Service Here **16**

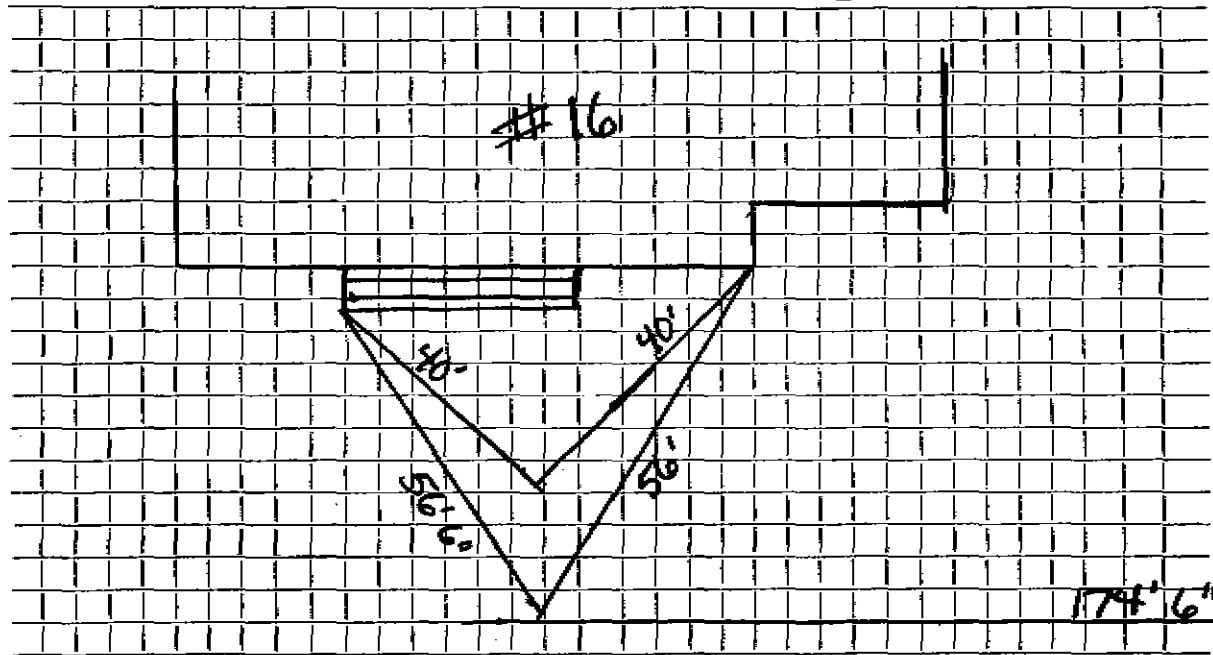

Essement  
m 66  
①

Connection made in ..... Street. Work completed .....

Remarks: .....

.....

.....