

Name

Service No.

Address 17 Vinebrook

17 Vine Brook Road

Location

Kind of Pipe

Size 6"

Size of Main 8"

Repair—Renewal—New Service


Location

Date	Material	Amount	Total	Date	Location	Amount
1929				8-31-93	outside	
					10' 8" 6" PVC	
					1-45° Bend w/maid	
					6x6 PVC to PVC ferruco	

DATE \_\_\_\_\_

TOWN OF LEXINGTON — BOARD OF PUBLIC WORKS  
SEWER DIVISION

Sketch of Service Here **17**

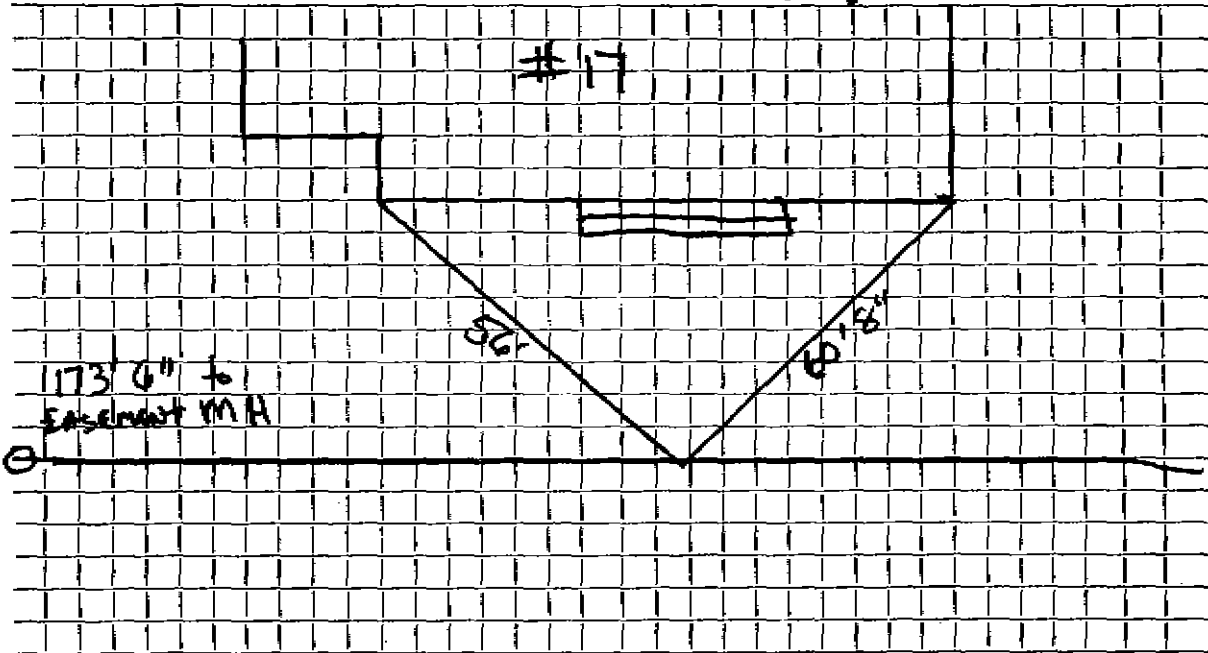

Connection made in ..... Street. Work completed .....

Remarks: .....

.....  
.....