



TOWN OF LEXINGTON—BOARD OF PUBLIC WORKS

SEWER DIVISION

DATE Nov 17-41

NO. \_\_\_\_\_

The undersigned applies for the construction of a particular sewer connecting No. 32. Van Hook St. Street and hereby agrees to comply with the Rules and Regulations governing the construction and use of Particular Sewers, as now or at any future time established by the Board of Selectmen.


Am't. of Estimate \$ 45.00

Am't. Paid \$ 45.00

Oliver J. J. J. J. Owner

Sketch of Service Here

22

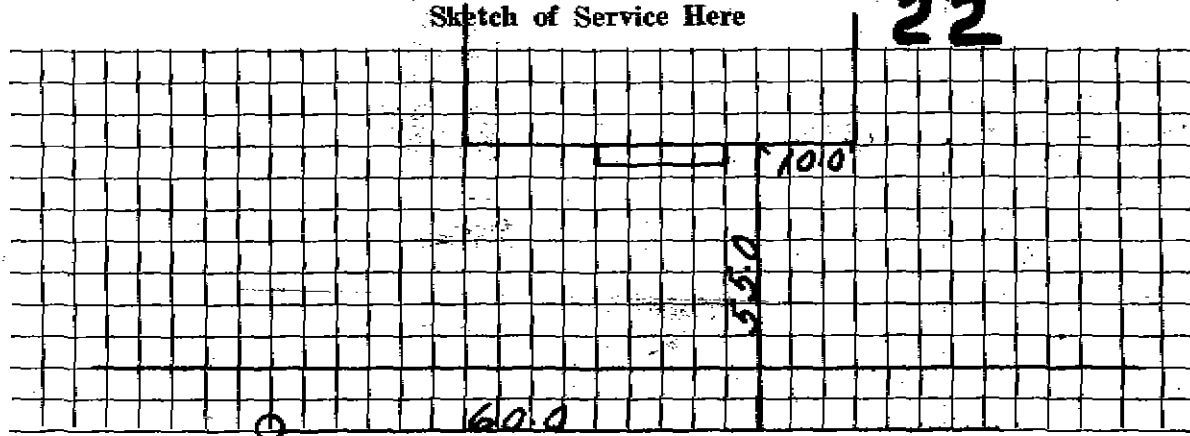

Connection made in \_\_\_\_\_ Street.

Work completed \_\_\_\_\_ 19

Remarks: .