

Name Lombard, Helen F.

Service No. 6

1524

Address 24 Vine Brook Road, Lexington

24 Vine Brook Road

Location Sme.

Kind of Pipe

Size 6"

Size of Main 8"

~~Repair-Renewal~~—New Service

Location

Date		Material	Amount	Total	Date		Amount
1936							
Apr. 30	40	hrs. labor @ 55¢	\$22 00		April 29, 1936	Deposited	53 00
	35	" " @ 60¢	21 00	43 00	May 13, 1936	Refunded	55
		10% Ovhd. on labor		4 30			54 45
	29'	6" Sewer Pipe @ 17¢	4 93				
		Joint. Comp.	72				
		Trucking 2 hrs. 75¢	1 50	7 15			
				54 45			
		Labor					

Hadley Press, Inc., Lexington

Comm. 5-12-36
\$54.45
to Russell

TOWN OF LEXINGTON—BOARD OF PUBLIC WORKS
SEWER DIVISION

DATE April 10, 1936.


NO. _____

The undersigned applies for the construction of a particular sewer connecting No. 24 Vine Brook Rd Street and hereby agrees to comply with the Rules and Regulations governing the construction and use of Particular Sewers, as now or at any future time established by the Board of Selectmen.

Am't. of Estimate \$ 55.00

Am't. Paid \$ _____

Helen F. Lombard Owner

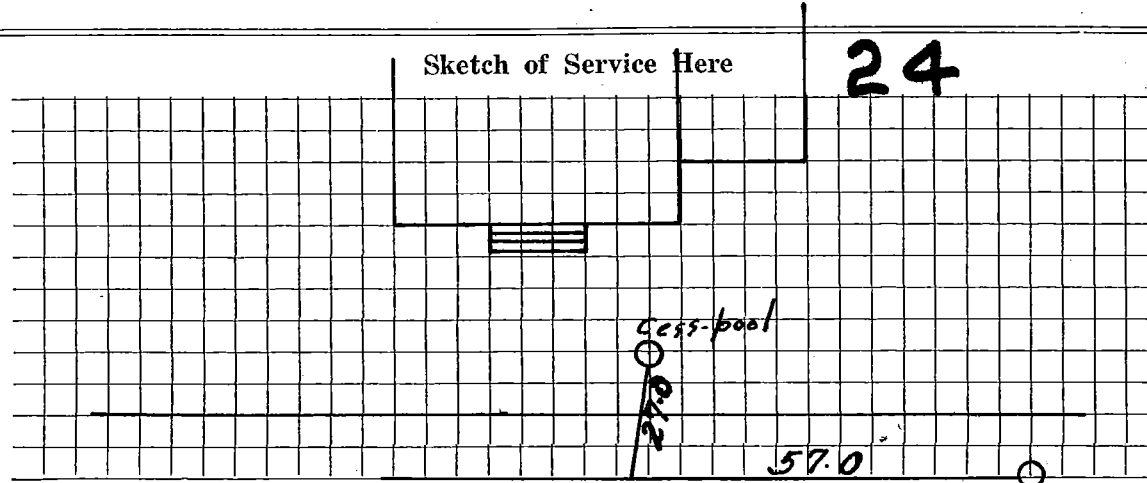

Connection made in _____ Street.

Work completed _____ 19

Remarks: