

Name Alfred P. Tropeano

Service No. 11 1525

Address ~~5 Sherman St., Lexington~~

25 Vine Brook Road

Location

25 Vine Brook Road

Kind of Pipe

Size 6"

Size of Main 8"

Repair—Renewal—New Service

Location

Date	Material	Amount	Total	Date	Amount
9/17/40	11½ hrs. @.55	6 33		September 13, 1940	75.00
Sum 17-31-40.	20½ hrs. .60	12 30	18 63	December 31, 1940	22.39
	10% Overhead		1 86		52.61
	38' 6" Sewer pipe @.16		6 08		
	1 6" Elbow		60		
	Joint Compound		2 28		
	Compressor, 5 hrs. @3.00		15 00		
	Trucking, 2 hrs. @ .75		1 50		
	Patching, 8' x 2'		6 66		
			\$52 61		
	Labor			2-25	50.15

Hadley Press, Inc., Lexington

Deposited
Refunded

TOWN OF LEXINGTON—BOARD OF PUBLIC WORKS
SEWER DIVISION

DATE ²⁸ Aug. 29, 1940

NO. _____

The undersigned applies for the construction of a particular sewer connecting No. 25 Vinebrook Road Street and hereby agrees to comply with the Rules and Regulations governing the construction and use of Particular Sewers, as now or at any future time established by the Board of Selectmen.

Am't. of Estimate \$ 120⁰⁰ Town

*Sum. of State 140⁰⁰ 100⁰⁰
 90⁰⁰ 100⁰⁰
 45⁰⁰*


224 1808-

Am't. Paid \$ _____

Alfred P. Tropeano Owner

Sketch of Service Here

25

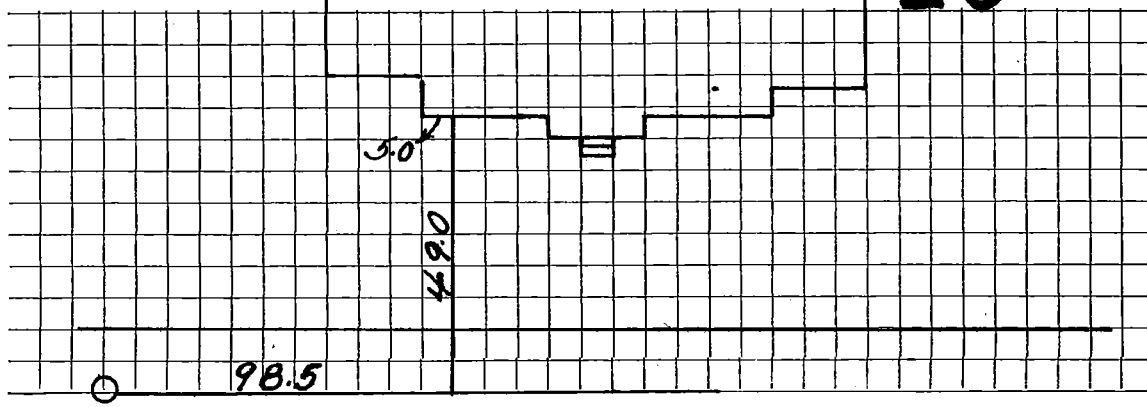

Connection made in _____ Street.

Work completed _____ 19

Remarks: