

Service No. 8

Address 26 Vine Brook Road, Lexington

26 Vine Brook Road Location Same

Size of Main 8"

Size 6"

Kind of Pipe

Reinforced Concrete - New Service

Location

Date	Material	Amount	Total	Date	Amount
1936 June 5	hrs. labor @ 55¢	31 35		May 14	80 00
June 6 2.00 to Russell 1.69 50	" @ 60¢	8 40	39 75	June 10	17 50
10¢	Overhd. on labor		3 98	Expanded	67 50
56¢	6" Pipe @ 16¢	8 96			
	Jointing Compound	2 81			
	Trucking	2 00			
	Trench Repairs	10 00	23 77		
			67 50		
	Labor				

Cess pool - filled in to prevent sewer gas?

# TOWN OF LEXINGTON - BOARD OF PUBLIC WORKS SEWER DIVISION

DATE April 27, 1936.

NO. \_\_\_\_\_


The undersigned applies for the construction of a particular sewer connecting No. 26 Vine Brook Road Street and hereby agrees to comply with the Rules and Regulations governing the construction and use of Particular Sewers, as now or at any future time established by the Board of Selectmen.

Am't. of Estimate \$ 80.00

Am't. Paid \$ \_\_\_\_\_

Wm B. F. Groot Owner

Sketch of Service Here

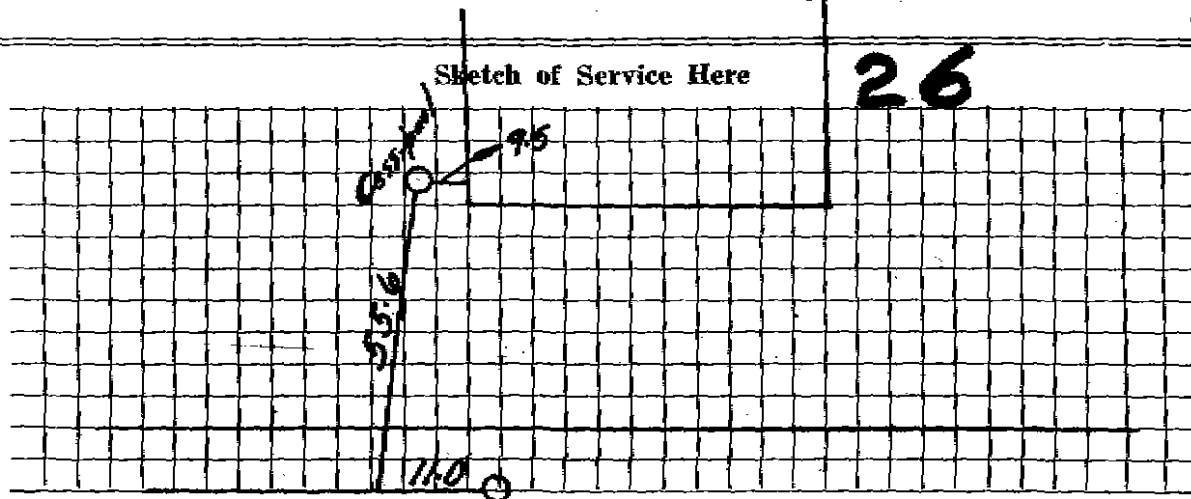

Connection made in \_\_\_\_\_ Street.

Work completed \_\_\_\_\_ 19

Remarks: