

1688 Mass. Ave. | Lexington

27 Vine Brook Rd.

Location

27 Vine Brook Road Cor Sherburne Rd.

Kind of Pipe

Size 6"

Size of Main 8"

~~Replaces~~ New Service

Location

Date 1941	Material	Amount	Total	Date	Amount
April 7	34 hrs. @ 60¢	20 64	✓	<i>April 11, 1941 Deposited</i>	41 08
<i>Jan 6/1941</i>	10% Overhead	2 06	✓	<i>June 14, 1941 Refunded</i>	2 73
	38' 6" Sewer Pipe @ 16¢		✓		42 27
	1 6" 1/4 Bend				
	Jointing compound		✓		
	Compressor		✓		
	Trucking- 2 hrs. @ 75¢		✓		
	Trench repairs				
			42 27		

(Refund of \$2.73 is to be credited to Sewer Service #3)

Labor

Halsey Bros. Inc., Lexington

TOWN OF LEXINGTON—BOARD OF PUBLIC WORKS

SEWER DIVISION

DATE

Apr. 2, 1941

NO.

The undersigned applies for the construction of a particular sewer connecting No. *27 Union Street* Street and hereby agrees to comply with the Rules and Regulations governing the construction and use of Particular Sewers, as now or at any future time established by the Board of Selectmen.


Am't. of Estimate \$ _____

Am't. Paid \$ _____

Colonial Garage Owner

Sketch of Service Here

27

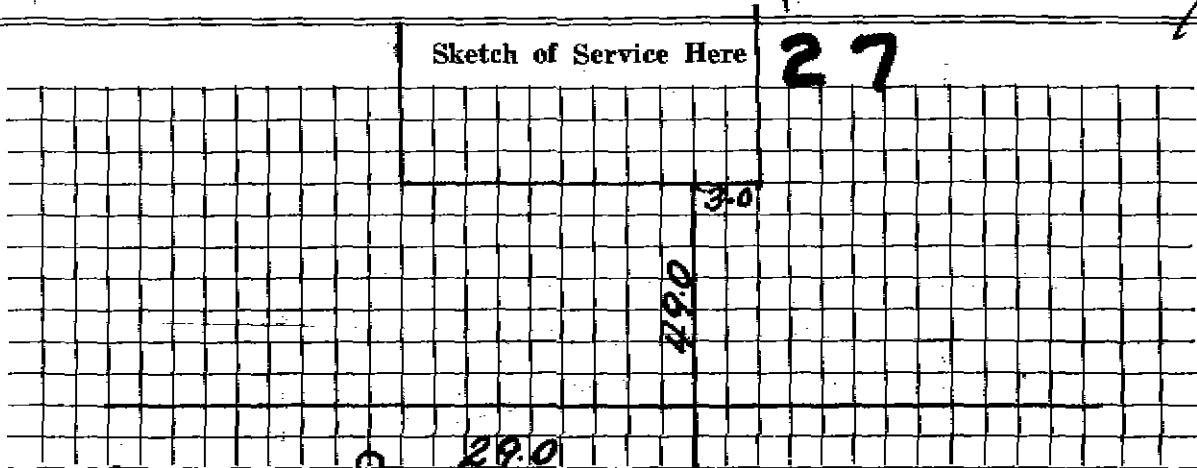

Connection made in _____ Street.

Work completed _____ 19

Remarks: