

Name Carl Janke

Service No. 3

Address 30 Vine Brook Road

30 Vine Brook Road

Location

Committed 4-2-56

Kind of Pipe

Size 6"

Size of Main 8"

~~Repair~~ New Service

Location

Date	Material	Amount	Total	Date	Amount
1-19-56	Labor	57 64		1-13-56	Deposited \$ 200 00
	10% Overhead	5 76	63 40	4-2-56	Refunded 15 84
	60' - 6" Sewer pipe @ .50		30 00		184 16
	Joint compound		3 60		
	8 2/3 hrs. Littlefield Shovel @ .50	8 50	73 66		
	2 hrs. trucking @ .75		1 50		
	12x3 patching		12 00		
			184 16		
	<b>Labor</b>			3-24-01	Respond + Measure Plumber out 40' ? + Mark out

**TOWN OF LEXINGTON—DEPT. OF PUBLIC WORKS  
SEWER DIVISION**

DATE.....

NO. ....


The undersigned applies for the construction of a particular sewer connecting No.....  
Street and hereby agrees to comply with the Rules and Regulations governing the construction and use of Particular  
Sewers, as now or at any future time established by the Board of Selectmen.

Am't of estimate \$. ....

Am't Paid \$. ....

..... Owner

**Sketch of Service Here 30**

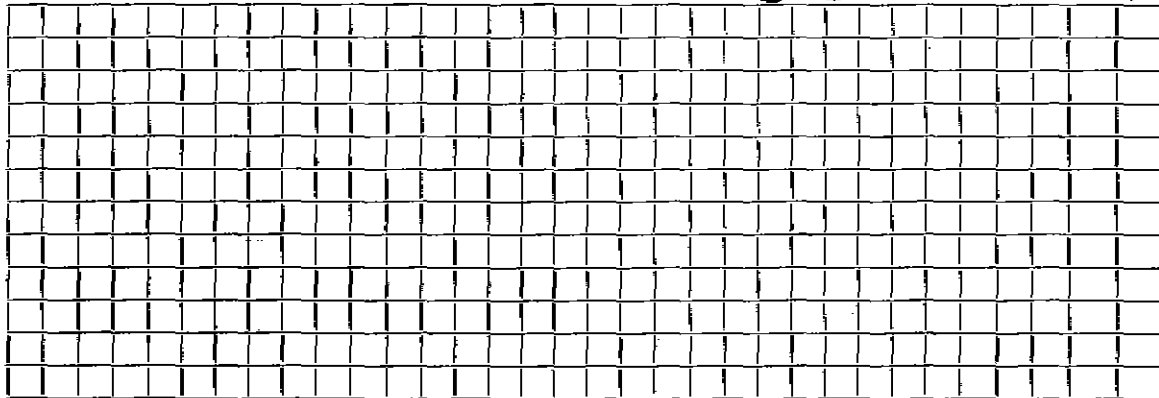

Connection made in..... Street. Work completed..... 19...

Remarks: