

Service No. 38-1524

Address **Forest Court, Lexington**

31 Vine Brook Rd., Locum St Vine Brook Road

Kind of Pipe **Size 6"** Size of Main **8"**

Revisions—New Service

Date	Material	Amount	Total	Date	Location	Amount
1936 8/20	48 hrs. labor @ 55¢	26 40				61 00
<i>same added</i>	12 " " @ 60¢	7 20	33 60	<i>Aug 8, 1936 Deposited</i>		
8-22-00	10% O'wind. on labor		3 36	<i>Sept 15, 1936 Refunded</i>		12 00
	38' 6" S. Pipe @ 17¢	6 46				53 00
	1 6" Bend	75				
	1 Reducer	60				
	Jointing Compound	1 90				
	Trucking	1 00	10 71			
	Trench Repairs		5 33			
			53 00			
	Labor					

TOWN OF LEXINGTON - BOARD OF PUBLIC WORKS
SEWER DIVISION

DATE August 6, 1926

NO. _____

The undersigned applies for the construction of a particular sewer connecting No. 31 Vine Brook Road Street and hereby agrees to comply with the Rules and Regulations governing the construction and use of Particular Sewers, as now or at any future time established by the Board of Selectmen.


Am't. of Estimate \$ _____

Am't. Paid \$ _____

H. S. Johnson Owner
W. H. Brown

Sketch of Service Here

31

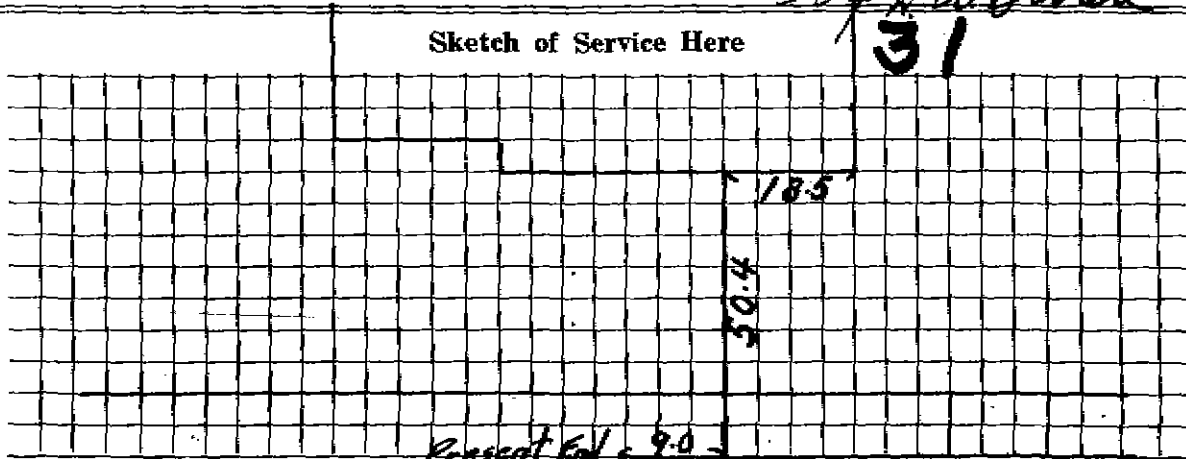

Connection made in _____ Street.

Work completed _____ 19

Remarks: