

Address 1808 Mass. Avenue

32 Vine Brook Road Location 32 Vine Brook Road

Kind of Pipe

Size 6"

Size of Main 8"

~~Repair~~ New Service

Location

Date 1941	Material	Amount	Total	Date	Amount
May 6.	10% Overhead on Labor		4 74		
	52 1/2 hrs. @ 50c	26 25		September 10, 1941	75 28
<i>5/27 6/30/41</i>	32 " @ 60c	19 20		<i>Paid</i>	
	3 " @ 65c	1 95	47 40		
	40' 6" Sewer Pipe @ 16c		6 40		
	Jointing compound		2 40		
	Trucking - 4 hrs. @ 75c		3 00		
	Trench repairs		11 34		
			75 28		
				<i>Bill sent July 2, 1941</i>	
	Labor				
				<i>8-1-66</i>	<i>Roots</i>

Hadley Press, Inc., Lexington

TOWN OF LEXINGTON—BOARD OF PUBLIC WORKS
SEWER DIVISION

DATE _____

NO. _____

The undersigned applies for the construction of a particular sewer connecting No. _____ Street and hereby agrees to comply with the Rules and Regulations governing the construction and use of Particular Sewers, as now or at any future time established by the Board of Selectmen.


Am't. of Estimate \$ _____

Am't. Paid \$ _____

Owner _____

Sketch of Service Here

32

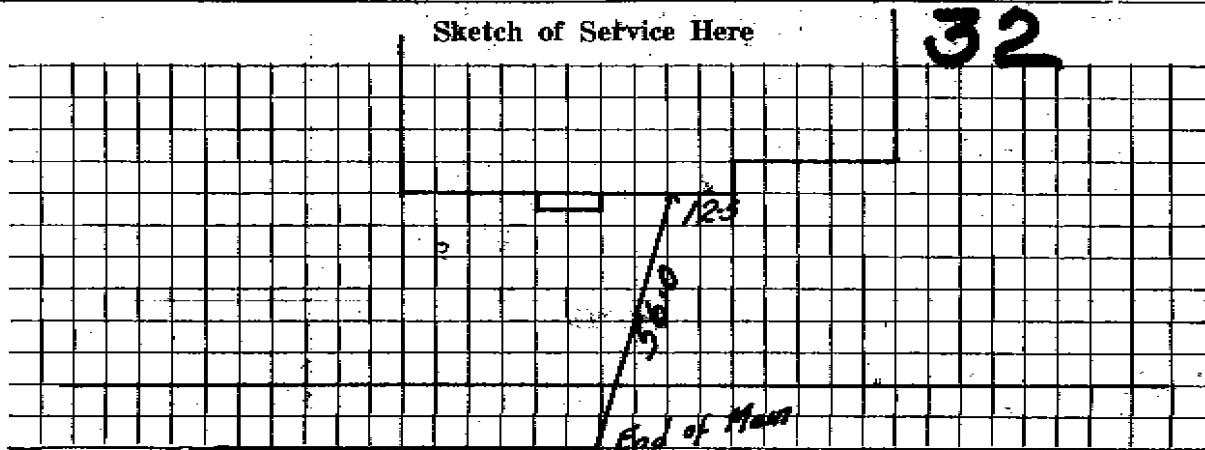

Connection made in _____ Street.

Work completed _____ 19 _____

Remarks: *Original Service 11-18-30*