


DATE 3.18.98

TOWN OF LEXINGTON — BOARD OF PUBLIC WORKS
SEWER DIVISION

Sketch of Service Here

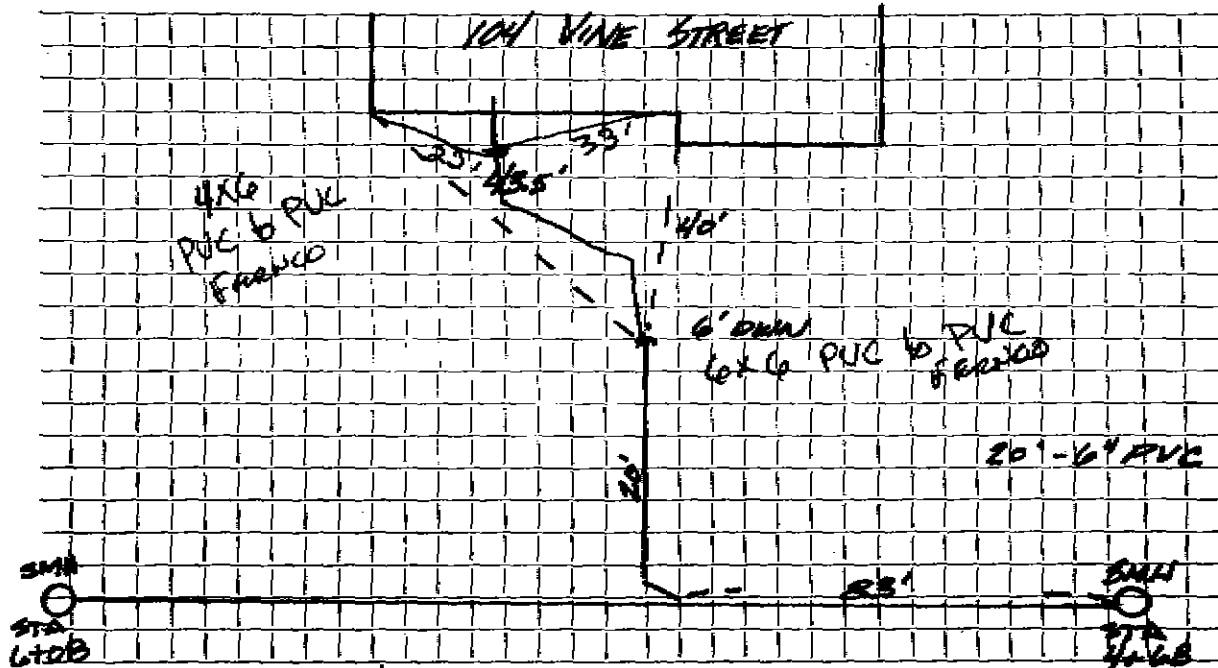

Connection made in VINE Street. Work completed CONTRACT 97A

Remarks: SERVICE CONNECTED TO HOUSE 10.1.98