


TOWN OF LEXINGTON — BOARD OF PUBLIC WORKS
DATE _____

SEWER DIVISION

Sketch of Service Here

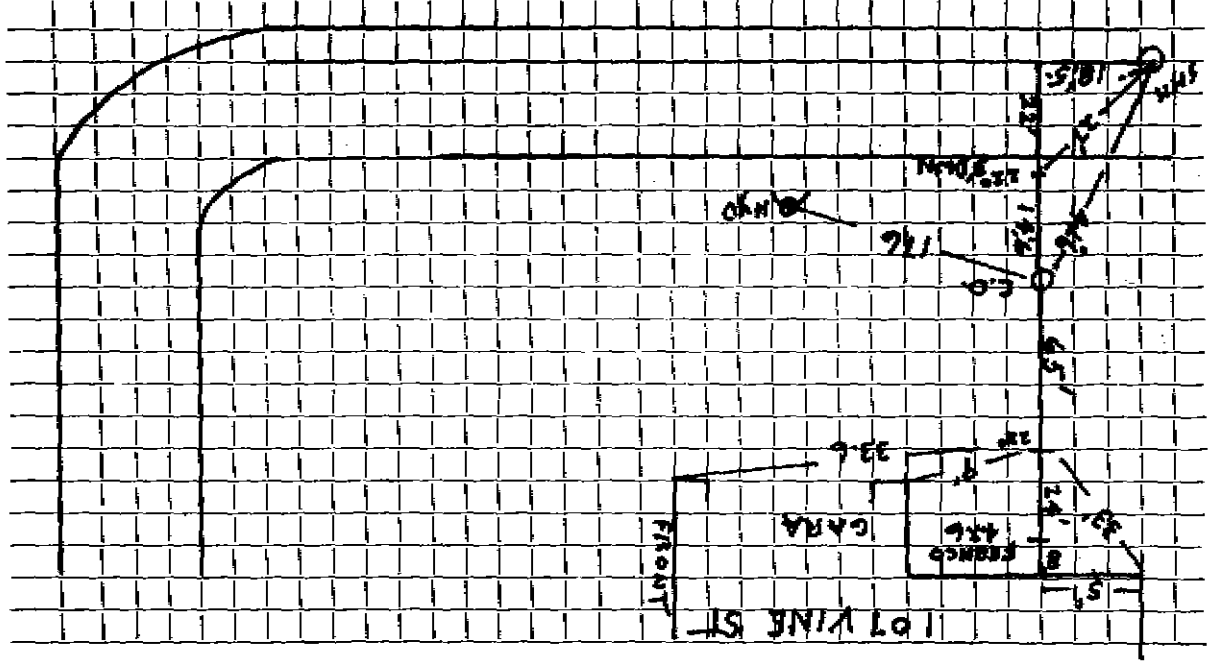

Connection made in KING ST Street. Work completed CONTRACT 77-7
Remarks: