

Name

Service No.

Address

117 Vine Street

Location

Kind of Pipe

Size 6"

Size of Main 8"

Repair—Renewal—New Service


Location

Date	Material	Amount	Total	Date	Amount
49'	6" P.V.C.				
10'	4" P.V.C.				
1	6"-22 1/2 Bend				
1	6" X 4" Fernco				

DATE \_\_\_\_\_

TOWN OF LEXINGTON — BOARD OF PUBLIC WORKS  
SEWER DIVISION

Sketch of Service Here **117**

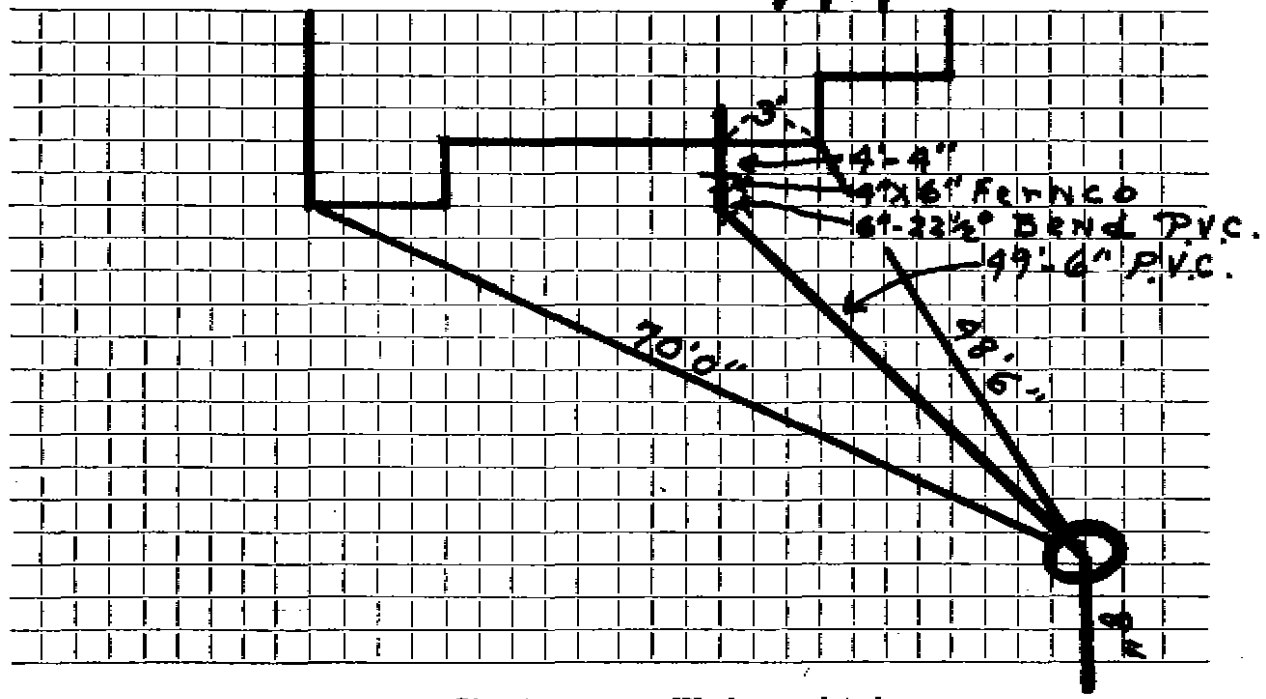

Connection made in ..... Street. Work completed .....

Remarks: .....  
.....  
.....