


DATE _____

TOWN OF LEXINGTON — BOARD OF PUBLIC WORKS

SEWER DIVISION

Sketch of Service Here

121

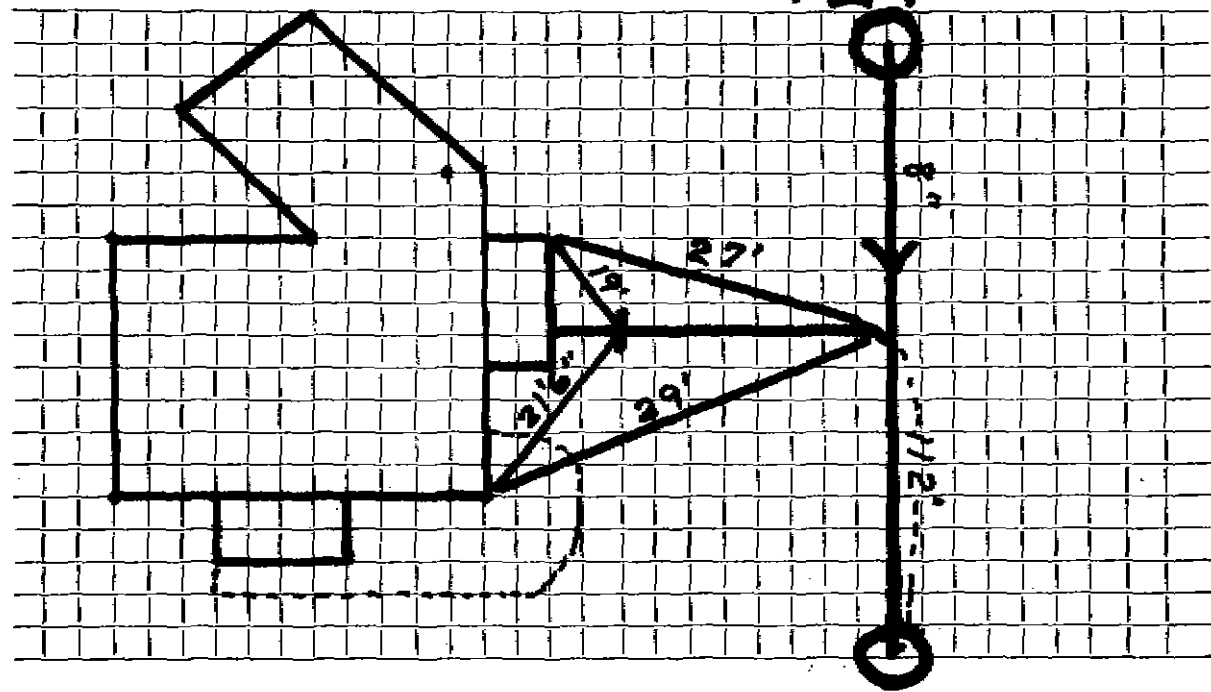

Connection made in Street. Work completed

Remarks:
.....
.....

11/24/95
Common


S.W.H. 2408.

VINE ST

11/97

Elbus

← 8" PVC Pipe

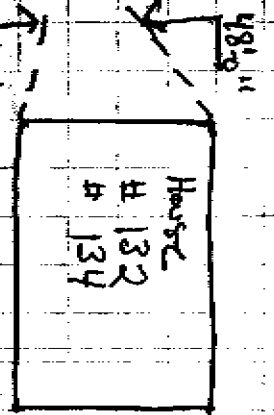

House
132
134

40'0"

to Existing
along fence
40'0"
50'0"
11'0" fence

8" S.W.H. In Vine Street 4463

South lot -
House -
11/16 and 132 Vine St.

S.W.H. Subur 2408

U.P. 15
103

Tru cut 190.2
Tru in 190.2
Ruv =

54'0"

2 Foot curb stob

N.E. of Section 3430

U.P. 103
33'0"

143'0"

S.W.H. In Vine Street 4463

Ruv =
Tru =
Tru and