

Name

Service No. 2371

Address

136 VINE ST

Location

Kind of Pipe PVC

Size 6"

Size of Main 8"

Repair—Renewal—New Service


J McLaughlin

Location

Date	Material	Amount	Total	Date	Amount
1/23/07	6.0 4" Sch 40				
	1' 4x6 F-rose				
	Also 6"-PVC				
	1' 6" PVC x 6" PVC F-rose				
	PVC—Service 5' Tub 9' 6" Pipe				
	EXIST				
11/91	PVC				

TOWN OF LEXINGTON — BOARD OF PUBLIC WORKS
 SEWER DIVISION
 DATE _____

Sketch of Service Here

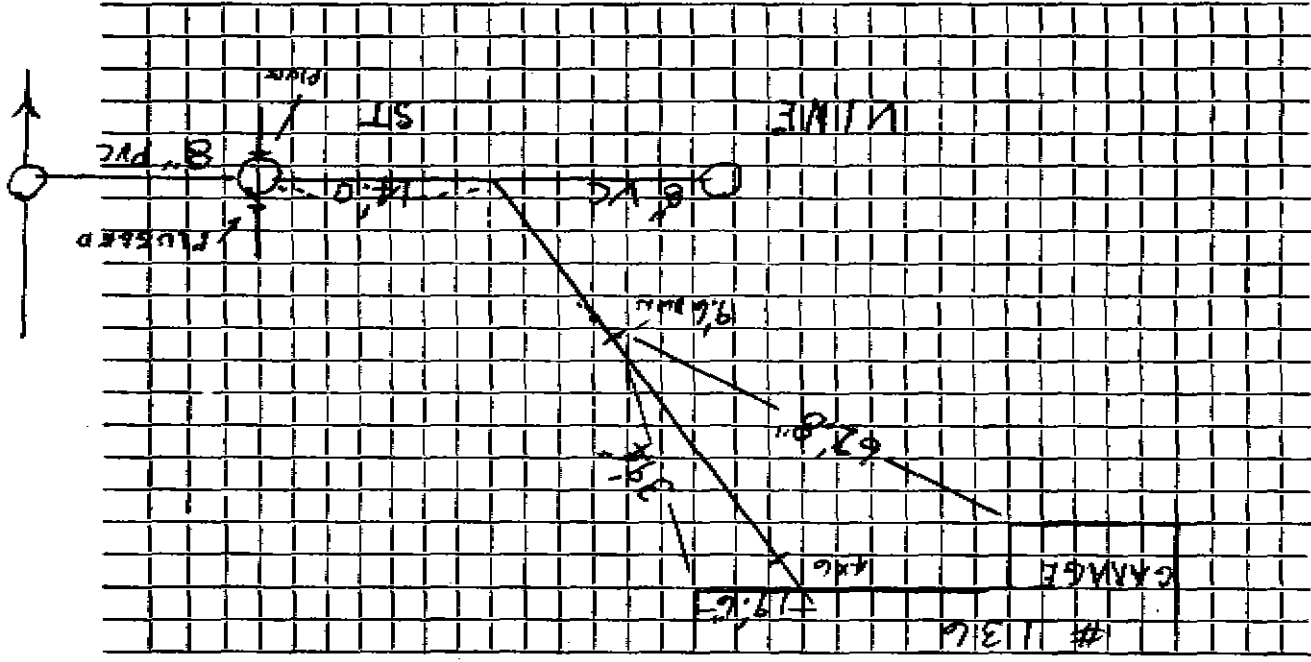

Connection made in KIPPS ST Street. Work completed 1/23/07 J. McLaughlin
 Remarks: