


DATE _____

TOWN OF LEXINGTON — BOARD OF PUBLIC WORKS
SEWER DIVISION

Sketch of Service Here

Chris Barry

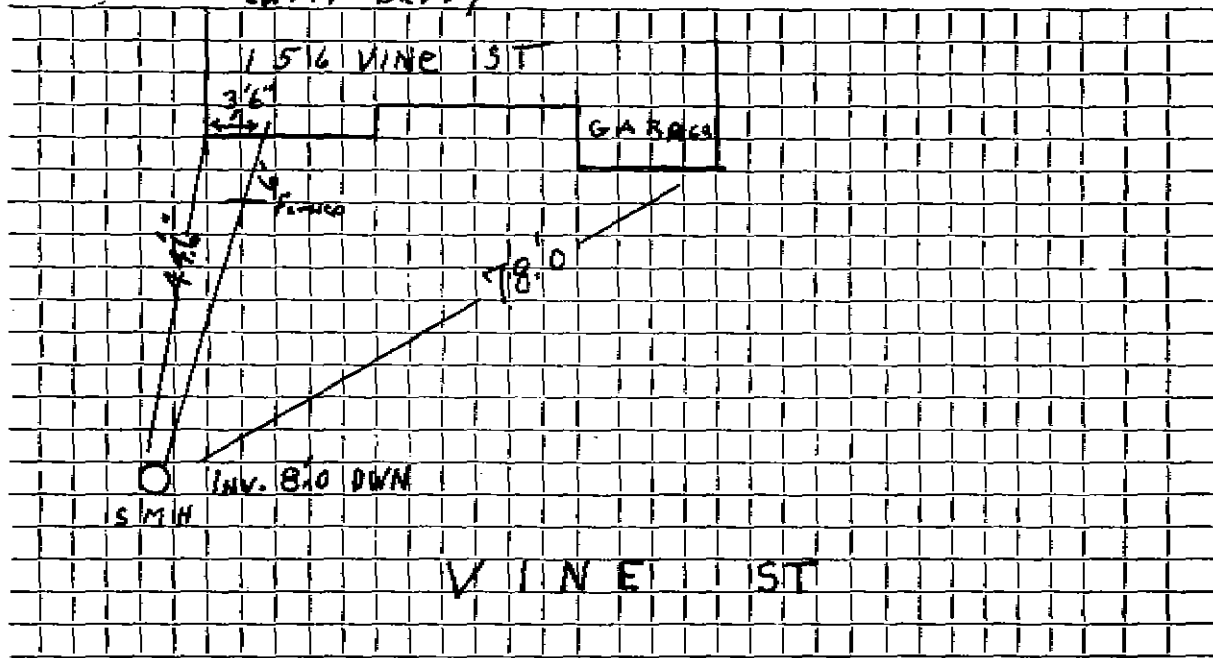

Connection made in VINE ST Street.

Work completed NOV 04 J. McLaughlin

Remarks:

.....

.....