

Name Della Mulvey

Service No. 36

Address 17 19 Vine Street

17 Vine Street

Location

Kind of Pipe Purchased from Lex. Lumber Co. Size 6"

Size of Main 8"

Repair - Renewal - New Service

Location

Date	Material	Amount	Total	Date	Amount
5/31/32	Sulphur & Jute	30			
5-26-32	Trucking	75		May 28 1932 - Cash	7 87
	6' 6" Pipe @ .14	84			
	1 1/2" Bend	65	2 54		
5/31/32	1 1/2 Hrs. Labor @ .65	97			
	6 ² " " @ .55	3 66	4 63		
	15% Overhead		70		
			7 87		
	Labor				

Hadley Press, Inc., Lexington

TOWN OF LEXINGTON—BOARD OF PUBLIC WORKS
SEWER DIVISION

DATE May 17/32

NO. _____


The undersigned applies for the construction of a particular sewer connecting No. 71 1/2 Vine Street Street and hereby agrees to comply with the Rules and Regulations governing the construction and use of Particular Sewers, as now or at any future time established by the Board of Selectmen.

Am't. of Estimate \$ _____

Am't. Paid \$ _____

Delia A. Mulvey Owner

Sketch of Service Here

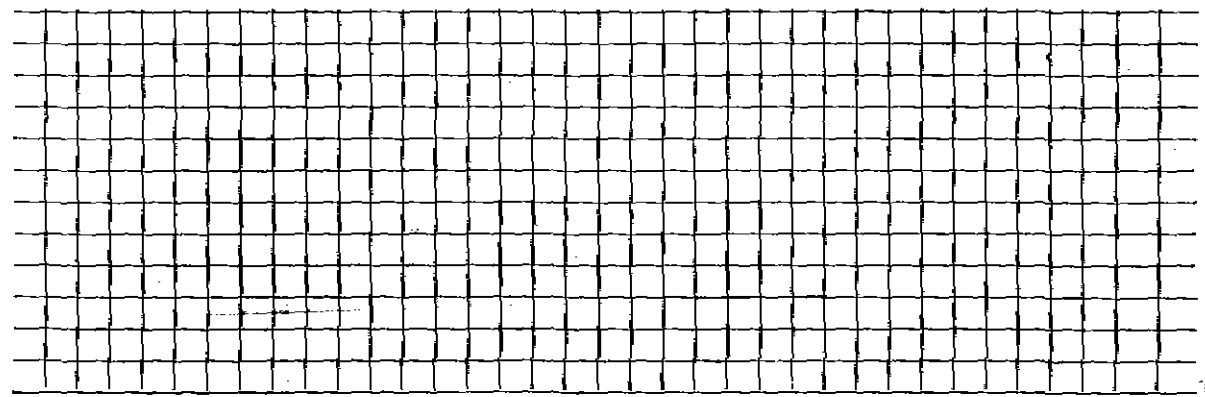

Connection made in _____ Street. Work completed _____ 19

Remarks: