

Name

Della Mulvey

Service No.

5 1506

Address

15 Boston Ave., W. Medford

16/18/20 Vine St. ~~15/18/20~~ Vine St.

Kind of Pipe

purchased from Lex. Lumber Size Co. 6"

Size of Main

8"

~~Regular~~ New Service

Location

Date	Material	Amount	Total	Date	Amount
1/2/32	1 1/8" Bend	65			
12-26 2/11	Sulphur & Jute	80		May 25 1932 Cook	12 26
	Trucking	75			
	16' 6" Pipe @ .14	<u>2 24</u>	4 44		
	2 Hrs. Labor @ .65	1 30			
	10 " " @ .55	<u>5 50</u>	6 80		
	15% Overhead		<u>1 02</u>		
			12 26		
	Labor				

TOWN OF LEXINGTON—BOARD OF PUBLIC WORKS

SEWER DIVISION

DATE May 17/32

NO. _____


The undersigned applies for the construction of a particular sewer connecting No. 742 Vine Street Street and hereby agrees to comply with the Rules and Regulations governing the construction and use of Particular Sewers, as now or at any future time established by the Board of Selectmen.

Am't. of Estimate \$ _____

Am't. Paid \$ _____

Delia A. Murphy Owner

Sketch of Service Here

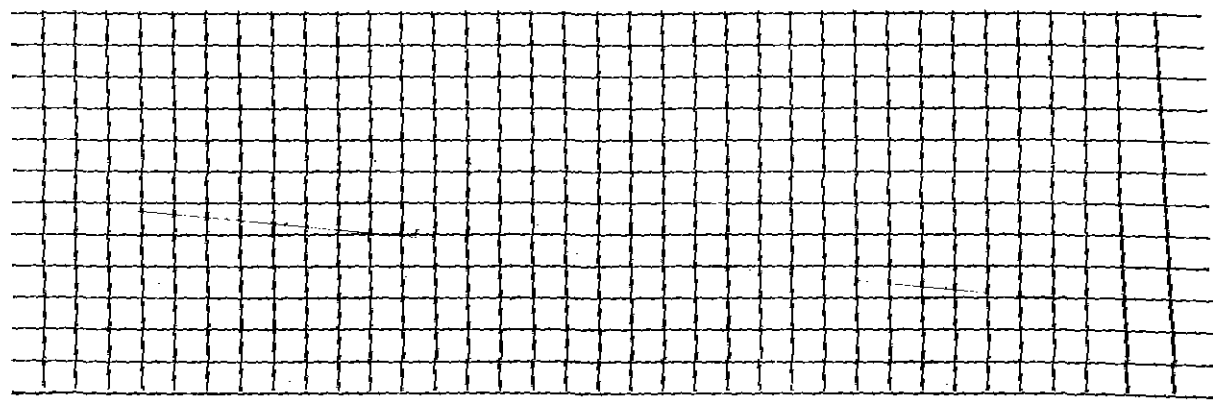

Connection made in _____ Street. Work completed _____ 19

Remarks:

Name

Della Milvey

Service No.

9 1807

Address

15 Boston Ave., W. Madford.

16/18/20 Vine St. Location 16/18/20 Vine St.

Kind of Pipe purchased from Lex. Lumber Size Co. 6"

Size of Main 8"

Service—New Service

Location

Date	Material	Amount	Total	Date	Amount
6/2/32	1 1/8" Bend	65			
Com-12-26	Sulphur & Jute	80			
6-21-32	Trucking	75			
	16' 6" Pipe @ .14	2 24	4 44		
	2 Hrs. Labor @ .65	1 30			
	10 " " @ .55	5 50	6 80		
	15% Overhead		1 02		
			12 26		
	Labor				

May 28 1932 Cash

12 26

Hadley Bros, Inc., Lexington

TOWN OF LEXINGTON—BOARD OF PUBLIC WORKS
SEWER DIVISION

DATE May 17/32

NO. _____


The undersigned applies for the construction of a particular sewer connecting No. 16-18-20 Vine Street and hereby agrees to comply with the Rules and Regulations governing the construction and use of Particular Sewers, as now or at any future time established by the Board of Selectmen.

Am't. of Estimate \$ _____

Am't. Paid \$ _____

Helia A. Mubrey Owner
(Signature)

Sketch of Service Here

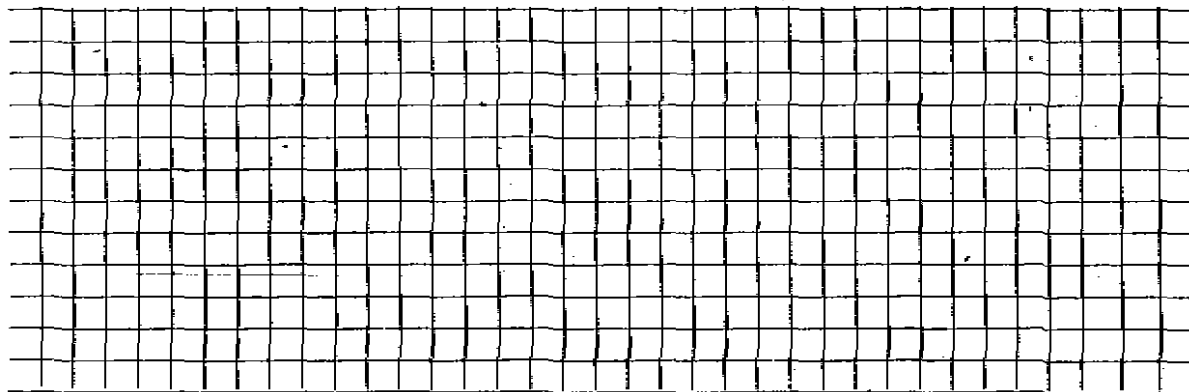

Connection made in _____ Street. Work completed _____ 19

Remarks: