

Name Lexington Visiting Nurse Assoc.

Service No. 6

Address 38 Hoburn Street, 21 Vine Street

21 Vine Street (11-1-77 per Eng.)

Location

Kind of Pipe

Size 6"

Size of Main 8"

~~Renewal~~ ~~New Service~~ W.O. #9576

Location MAY 17 1965

Date	Material	Amount	Total	Date	Amount
11-65	Labor	44.60		3-8-65	Deposit 440.00
12-65	"	128.26		5-17-65	Retard 43.64
20-65	"	21.21	194.07		396.36
	10% O.E.	19.41	213.48		
	95' 6" Transite pipe @.82		77.90		
	1 bag cement		1.50		
	1 90° transite elbow		4.09		
	1 11½° transite bend		4.09		
	12 x 3 Patch		12.00		
	5 hrs. Town Shovel @6.50		32.50		
	5 hrs. Trucking @3.00		15.00		
	10 yds. loam @3.00		30.00		
	½ bag fertlizer		2.00		
	4 lbs. Seed @.95		3.80		
			396.36		


DATE \_\_\_\_\_

TOWN OF LEXINGTON — BOARD OF PUBLIC WORKS

SEWER DIVISION

Sketch of Service Here

21

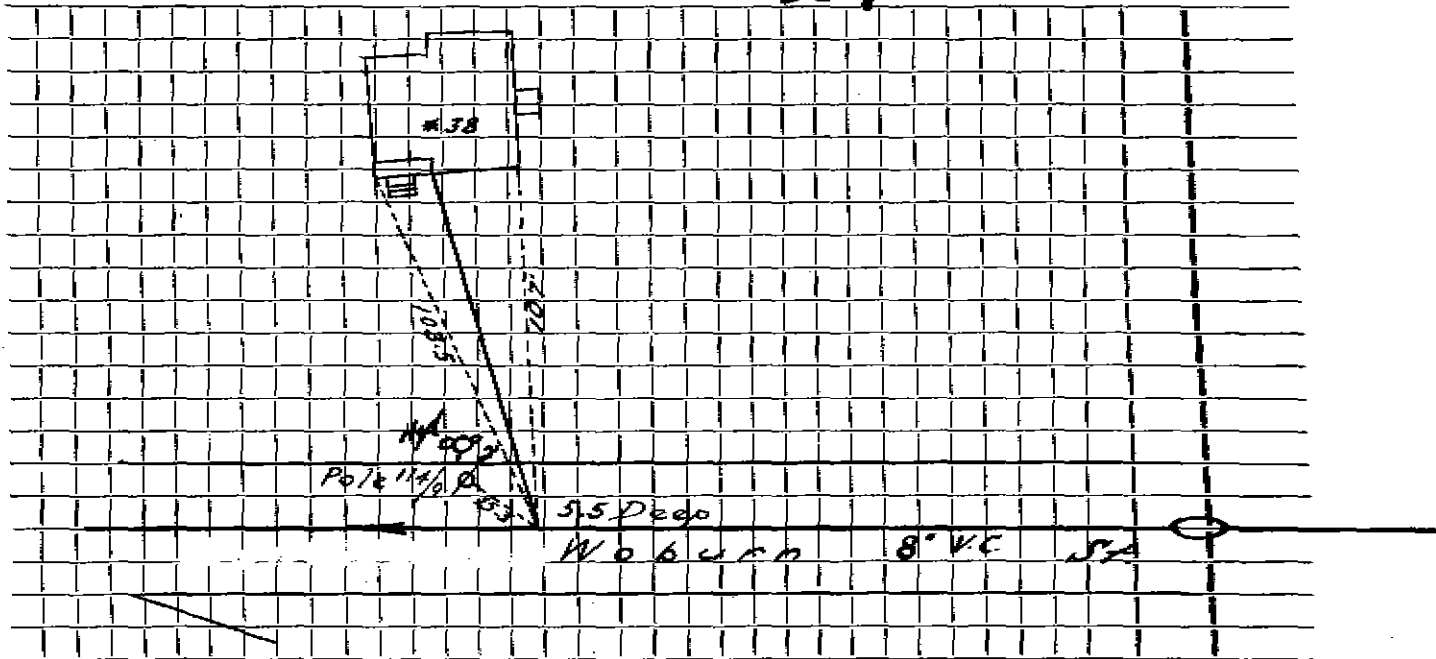

Connection made in ..... Street. Work completed .....

Remarks: Sewer is 2 FT to right of Hyd .....